



PT. GAYA MOTOR
RENOVASI AREA TIMUR KARAWANG PLANT/GM-KP

**CIVIL, ELECTRICAL & PLUMBING WORK
AS-BUILT DRAWING
27 DESEMBER 2025**


PT. GAYA MOTOR		
Approved By	Checked By	Checked By






PT. BUMI REKAYASA MANDIRI


NOTE	
PROJECT NAME	RENOVASI AREA TIMUR KARAWANG PLANT/GM-KP
CUSTOMER	
APPROVED BY CUSTOMER	
CONTRACTOR	
PROJECT MANAGER	
ENGINEERING	
DRAWING TITLE	
DAFTAR GAMBAR	
27 DESEMBER 2025	
SCALE	KODE
NTS	CV-00
NO.SHEET	CV-00
PAPER	A3

NO	KODE GAMBAR	JUDUL GAMBAR	SKALA
0	CV-00	DAFTAR GAMBAR	NTS
1	CV-01	LAYOUT LOCATION PROJECT	1:1200
2	CV-02	DENAH EXISTING & TAMPAK A (AREA TOILET TIMUR)	1:80
3	CV-03	DENAH AKTUAL & TAMPAK B (AREA TOILET TIMUR)	1:80
4	CV-04	DENAH PINTU & DETAIL PINTU	1:150
5	CV-05	DENAH FINISHING LANTAI	1:400
6	P-06	DENAH JALUR AIR BERSIH AREA PRODUKSI, AREA TOILET TIMUR & DETAIL SUPPORT PIPA AIR BERSIH	1:450
7	P-07	ISOMETRIC JALUR WATER SUPPLY	NTS
8	P-08	DENAH AIR KOTOR AREA TOILET TIMUR	1:100
9	E-09	DENAH ELECTRICAL & ISOMETRIC AREA TOILET TIMUR	1:100
10	E-10	DENAH ELECTRICAL & TAMPAK SUPPORT LAMP AREA PRODUKSI	1:500
11	E-11	DETAIL SUPPORT LAMP & CABLE TRAY	1:20
12	E-12	ISOMETRIC SUPPORT LAMP	NTS
13	E-13	DETAIL BOX PANEL SDP JUNBIKI 01	1:10
14	E-14	SINGLE LINE DIAGRAM & SPECIFIACIION BOX PANEL	NTS

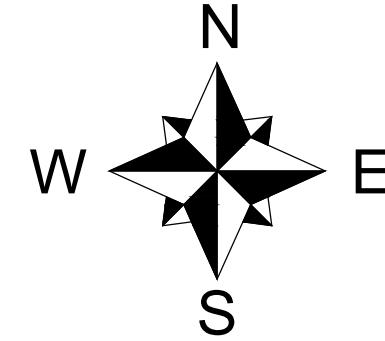


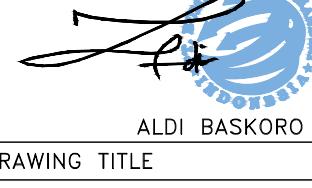NOTE			
PROJECT NAME	RENOVASI AREA TIMUR KARAWANG PLANT/GM-KP		
CUSTOMER			
APPROVED BY CUSTOMER			
CONTRACTOR	 PT. BUMI REKAYASA MANDIRI		
PROJECT MANAGER	 PORSAID		
ENGINEERING	 ALDI BASKORO .S		
DRAWING TITLE	LAYOUT LOCATION PROJECT		
27 DESEMBER 2025			
SCALE	KODE	NO.SHEET	PAPER
1:1200	CV-01	CV-01	A3

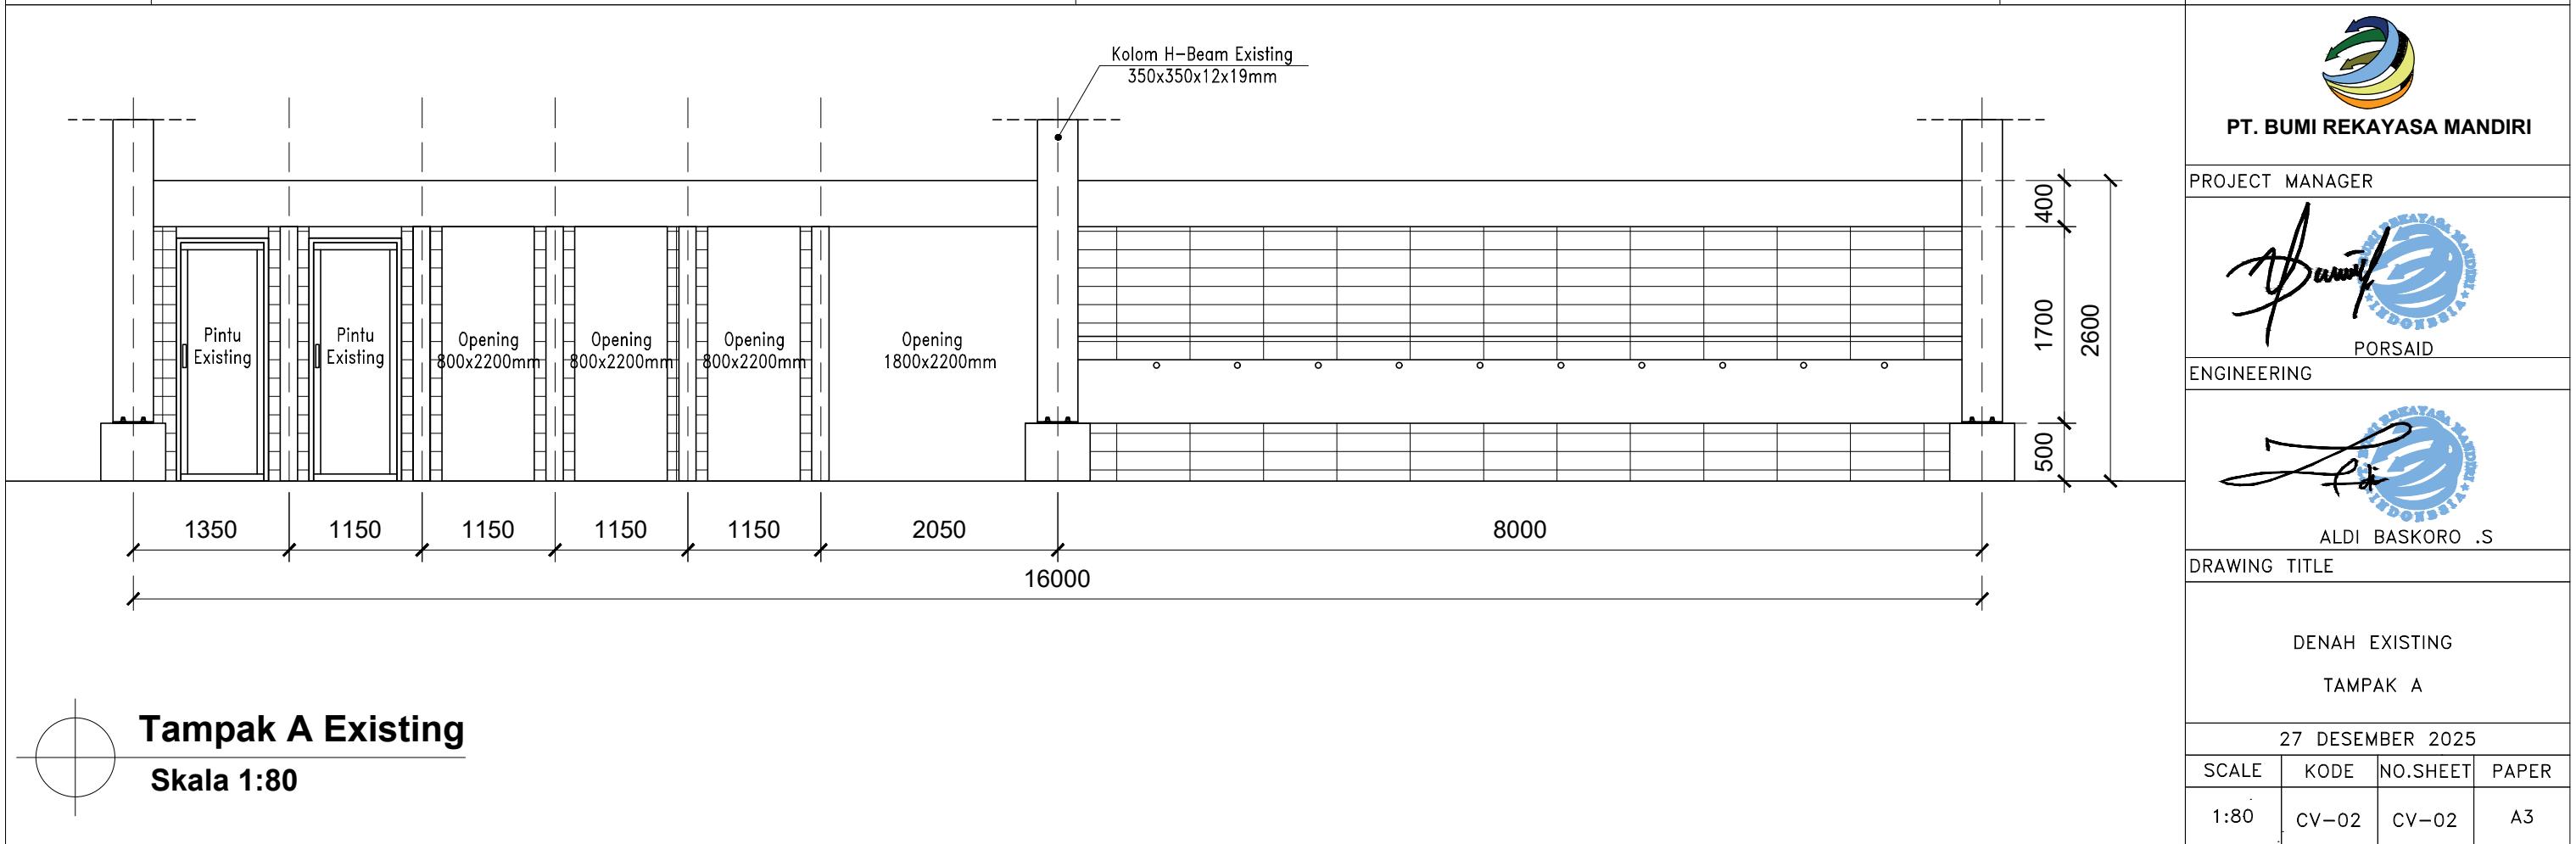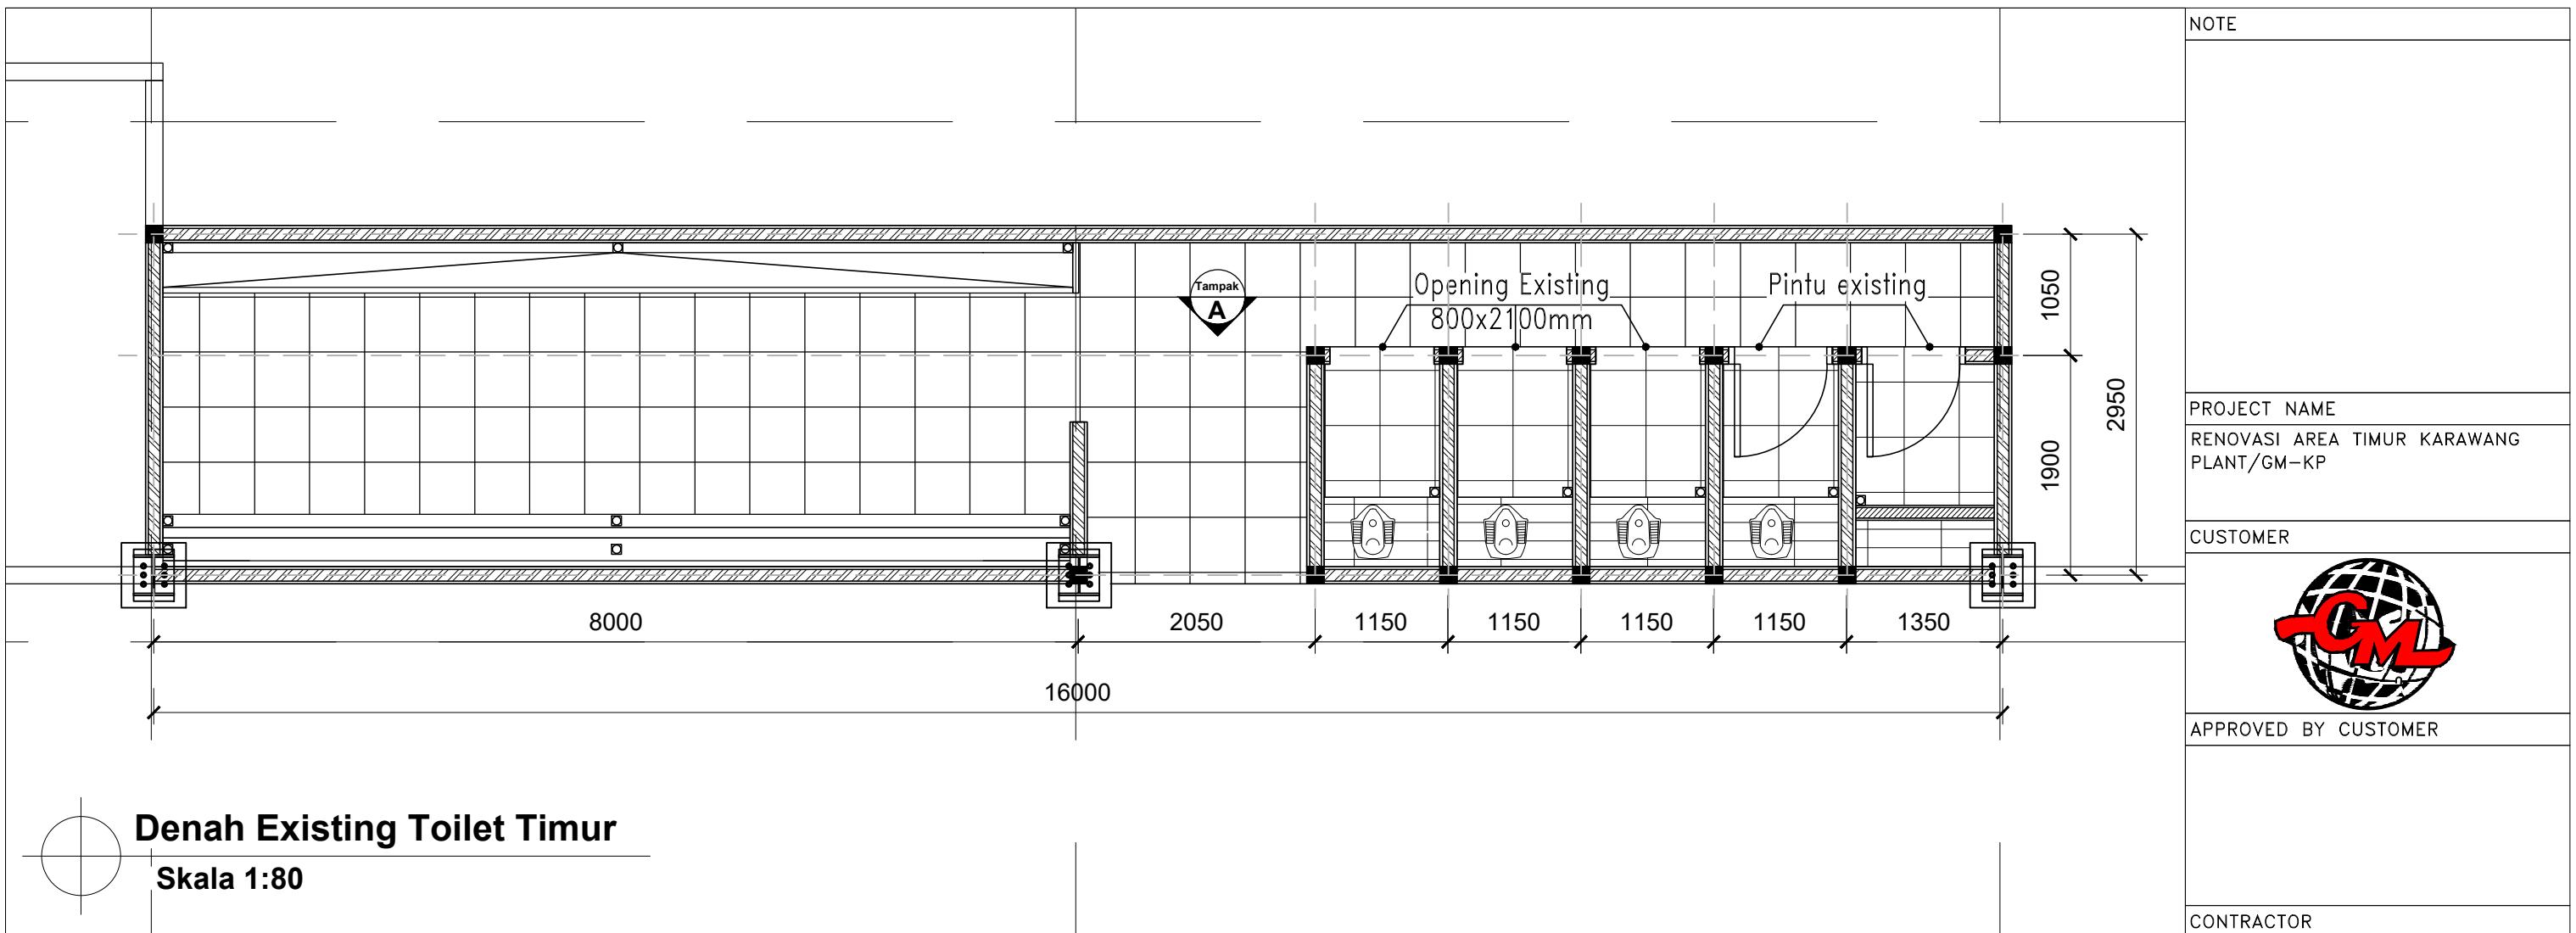


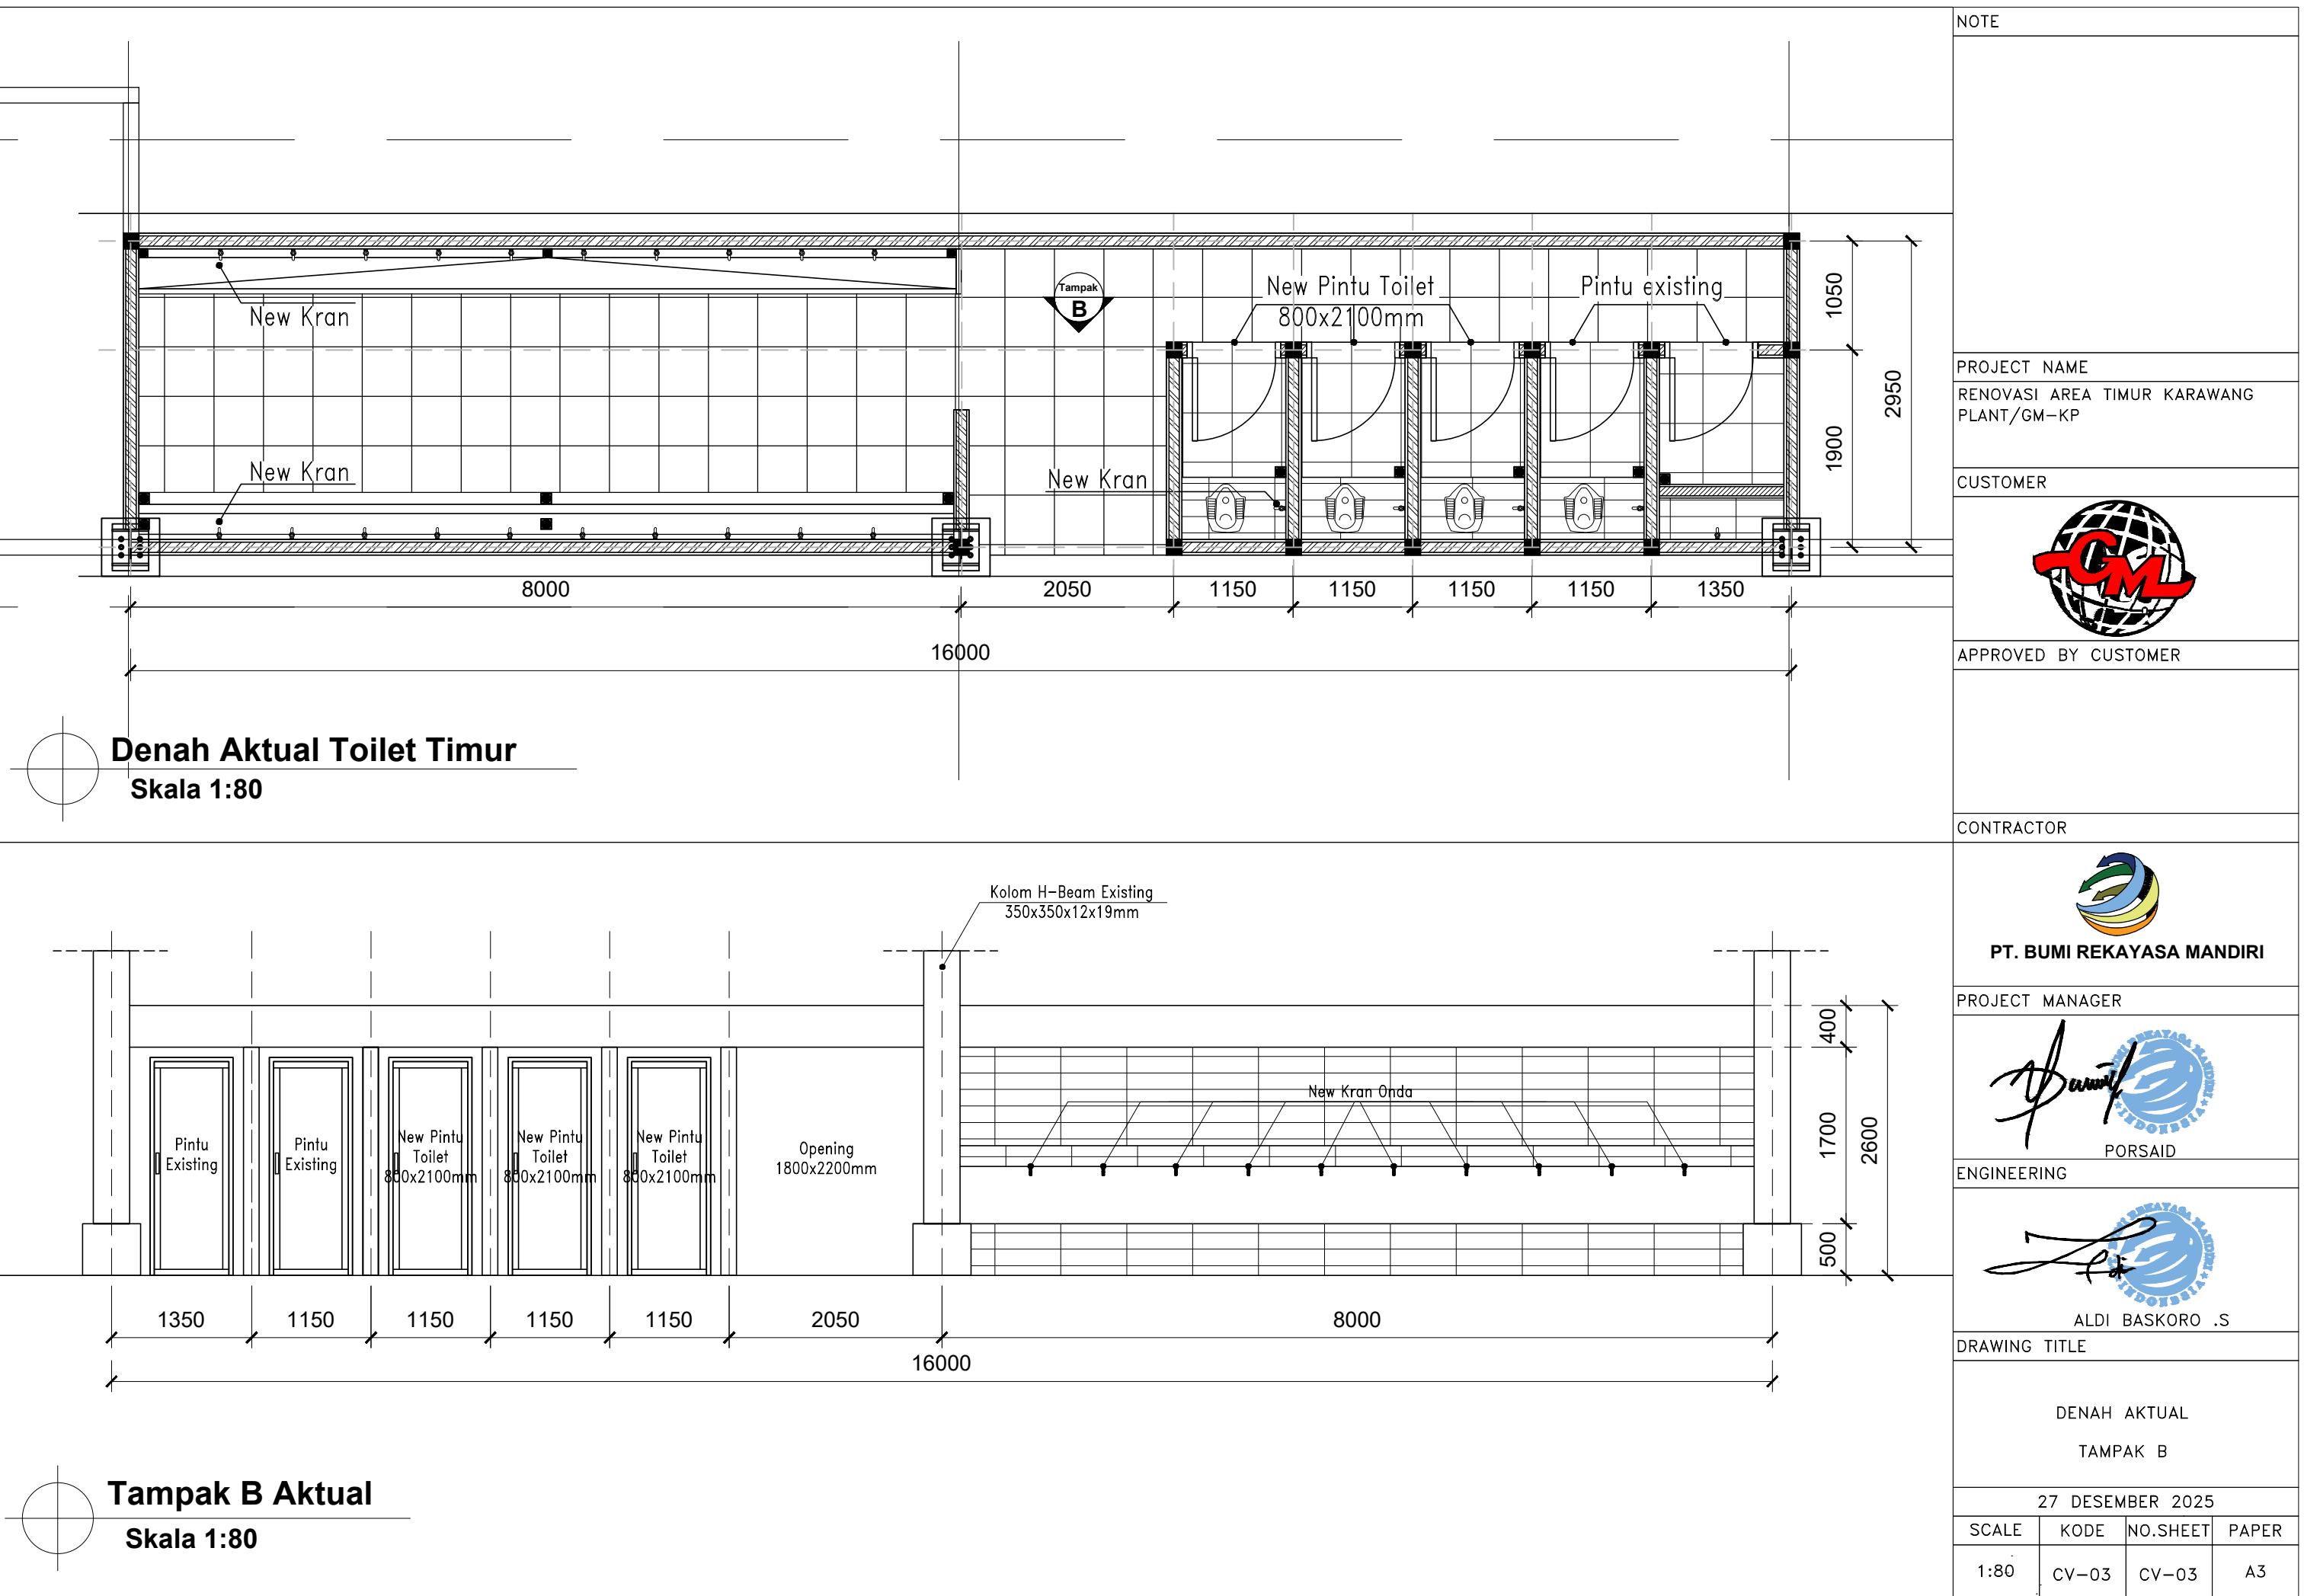


												NOTE
												PROJECT NAME
RENOVASI AREA TIMUR KARAWANG PLANT/GM-KP												
												CUSTOMER
												APPROVED BY CUSTOMER
												CONTRACTOR
												PT. BUMI REKAYASA MANDIRI
												PROJECT MANAGER
 												PORSAID
												ENGINEERING
 												ALDI BASKORO .S
												DRAWING TITLE
DENAH PINTU DETAIL PINTU												
27 DESEMBER 2025												
SCALE	KODE	NO.SHEET	PAPER									
1:150 1:45	CV-04	CV-04	A3									

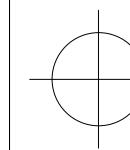


Denah Pintu

Skala 1:150

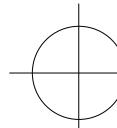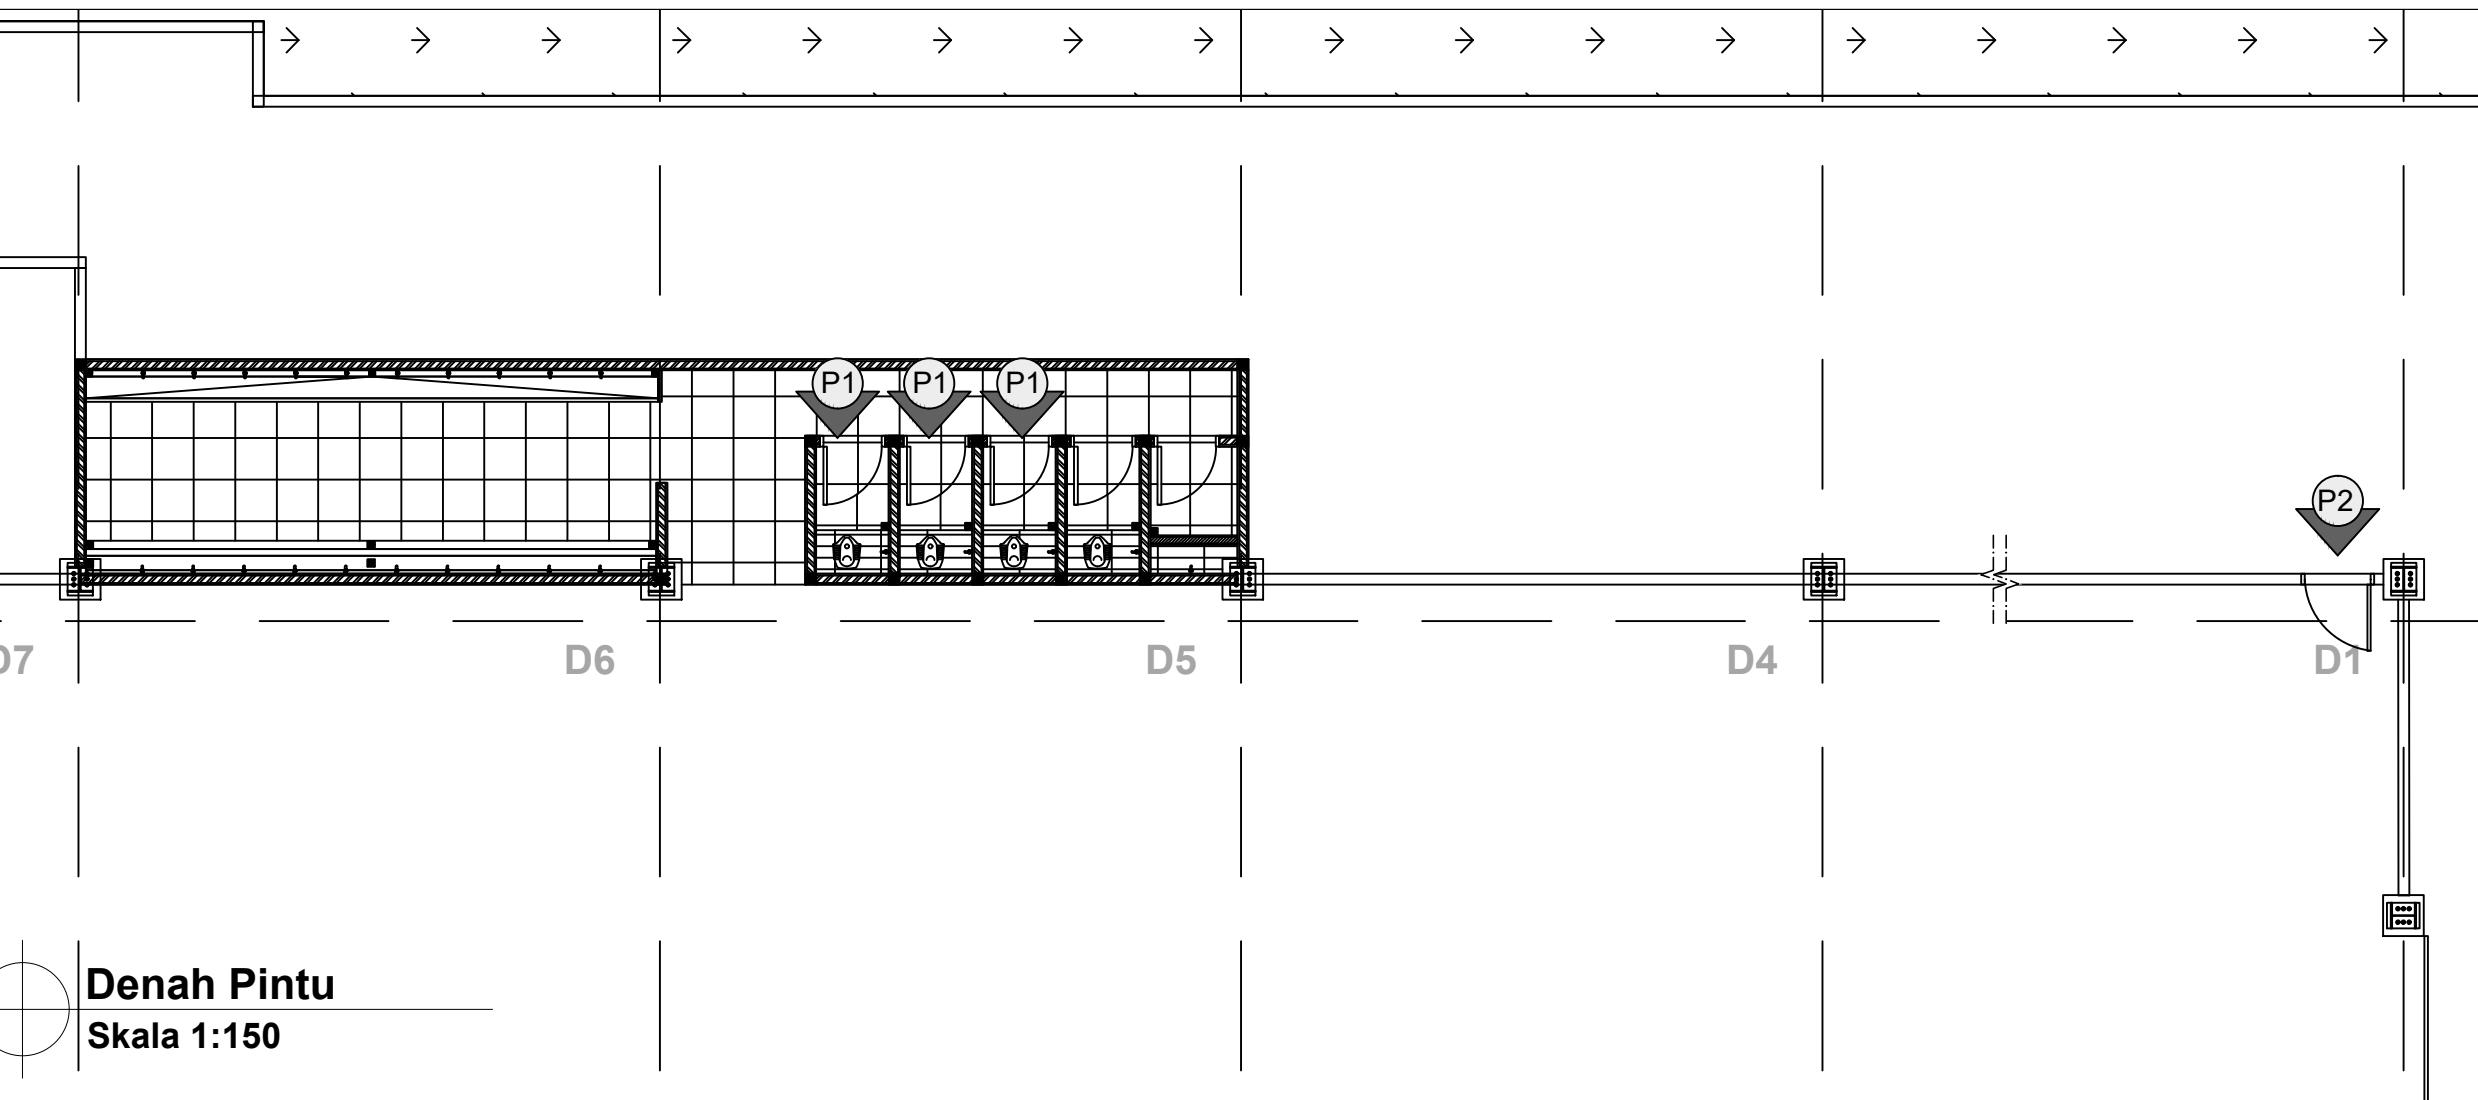



Detail Pintu (P1)


Skala 1:45


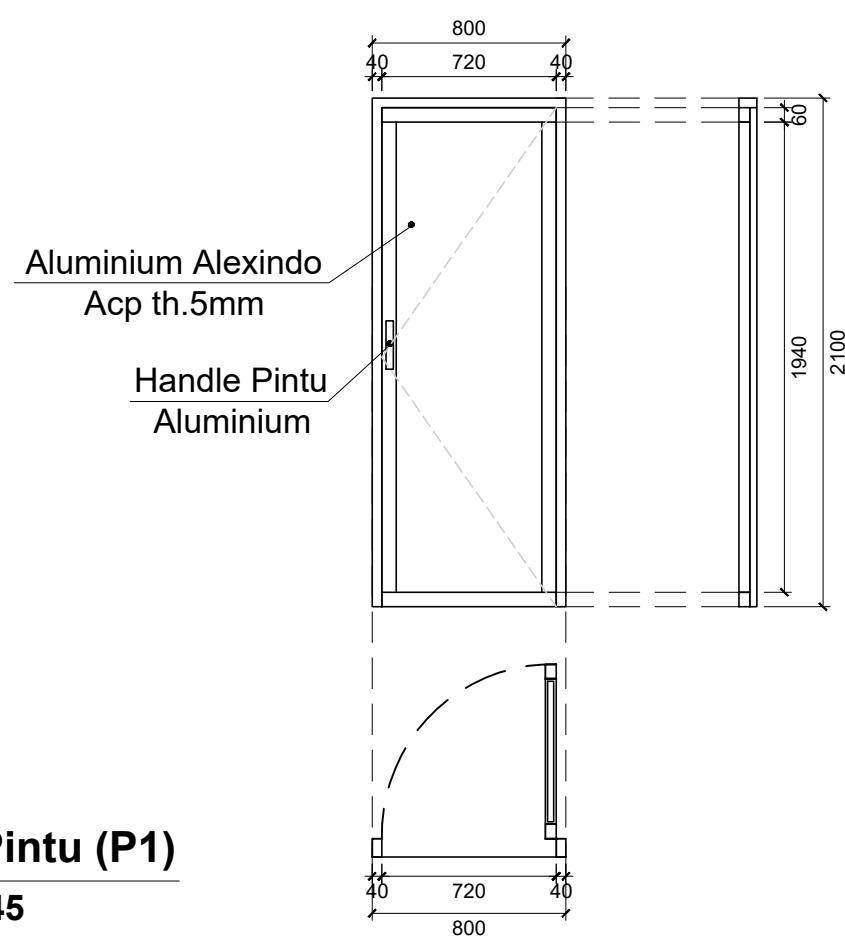


Detail Pintu (P2)

Skala 1:45

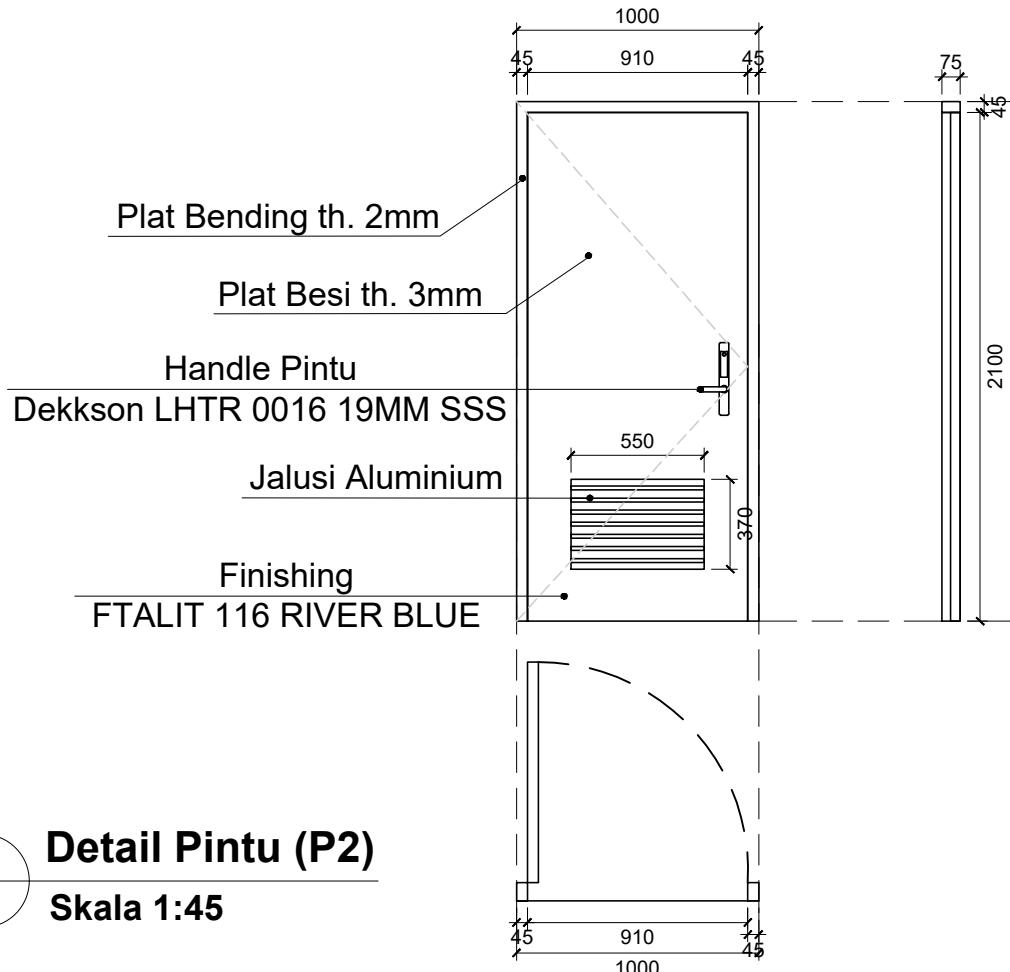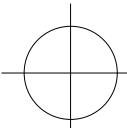


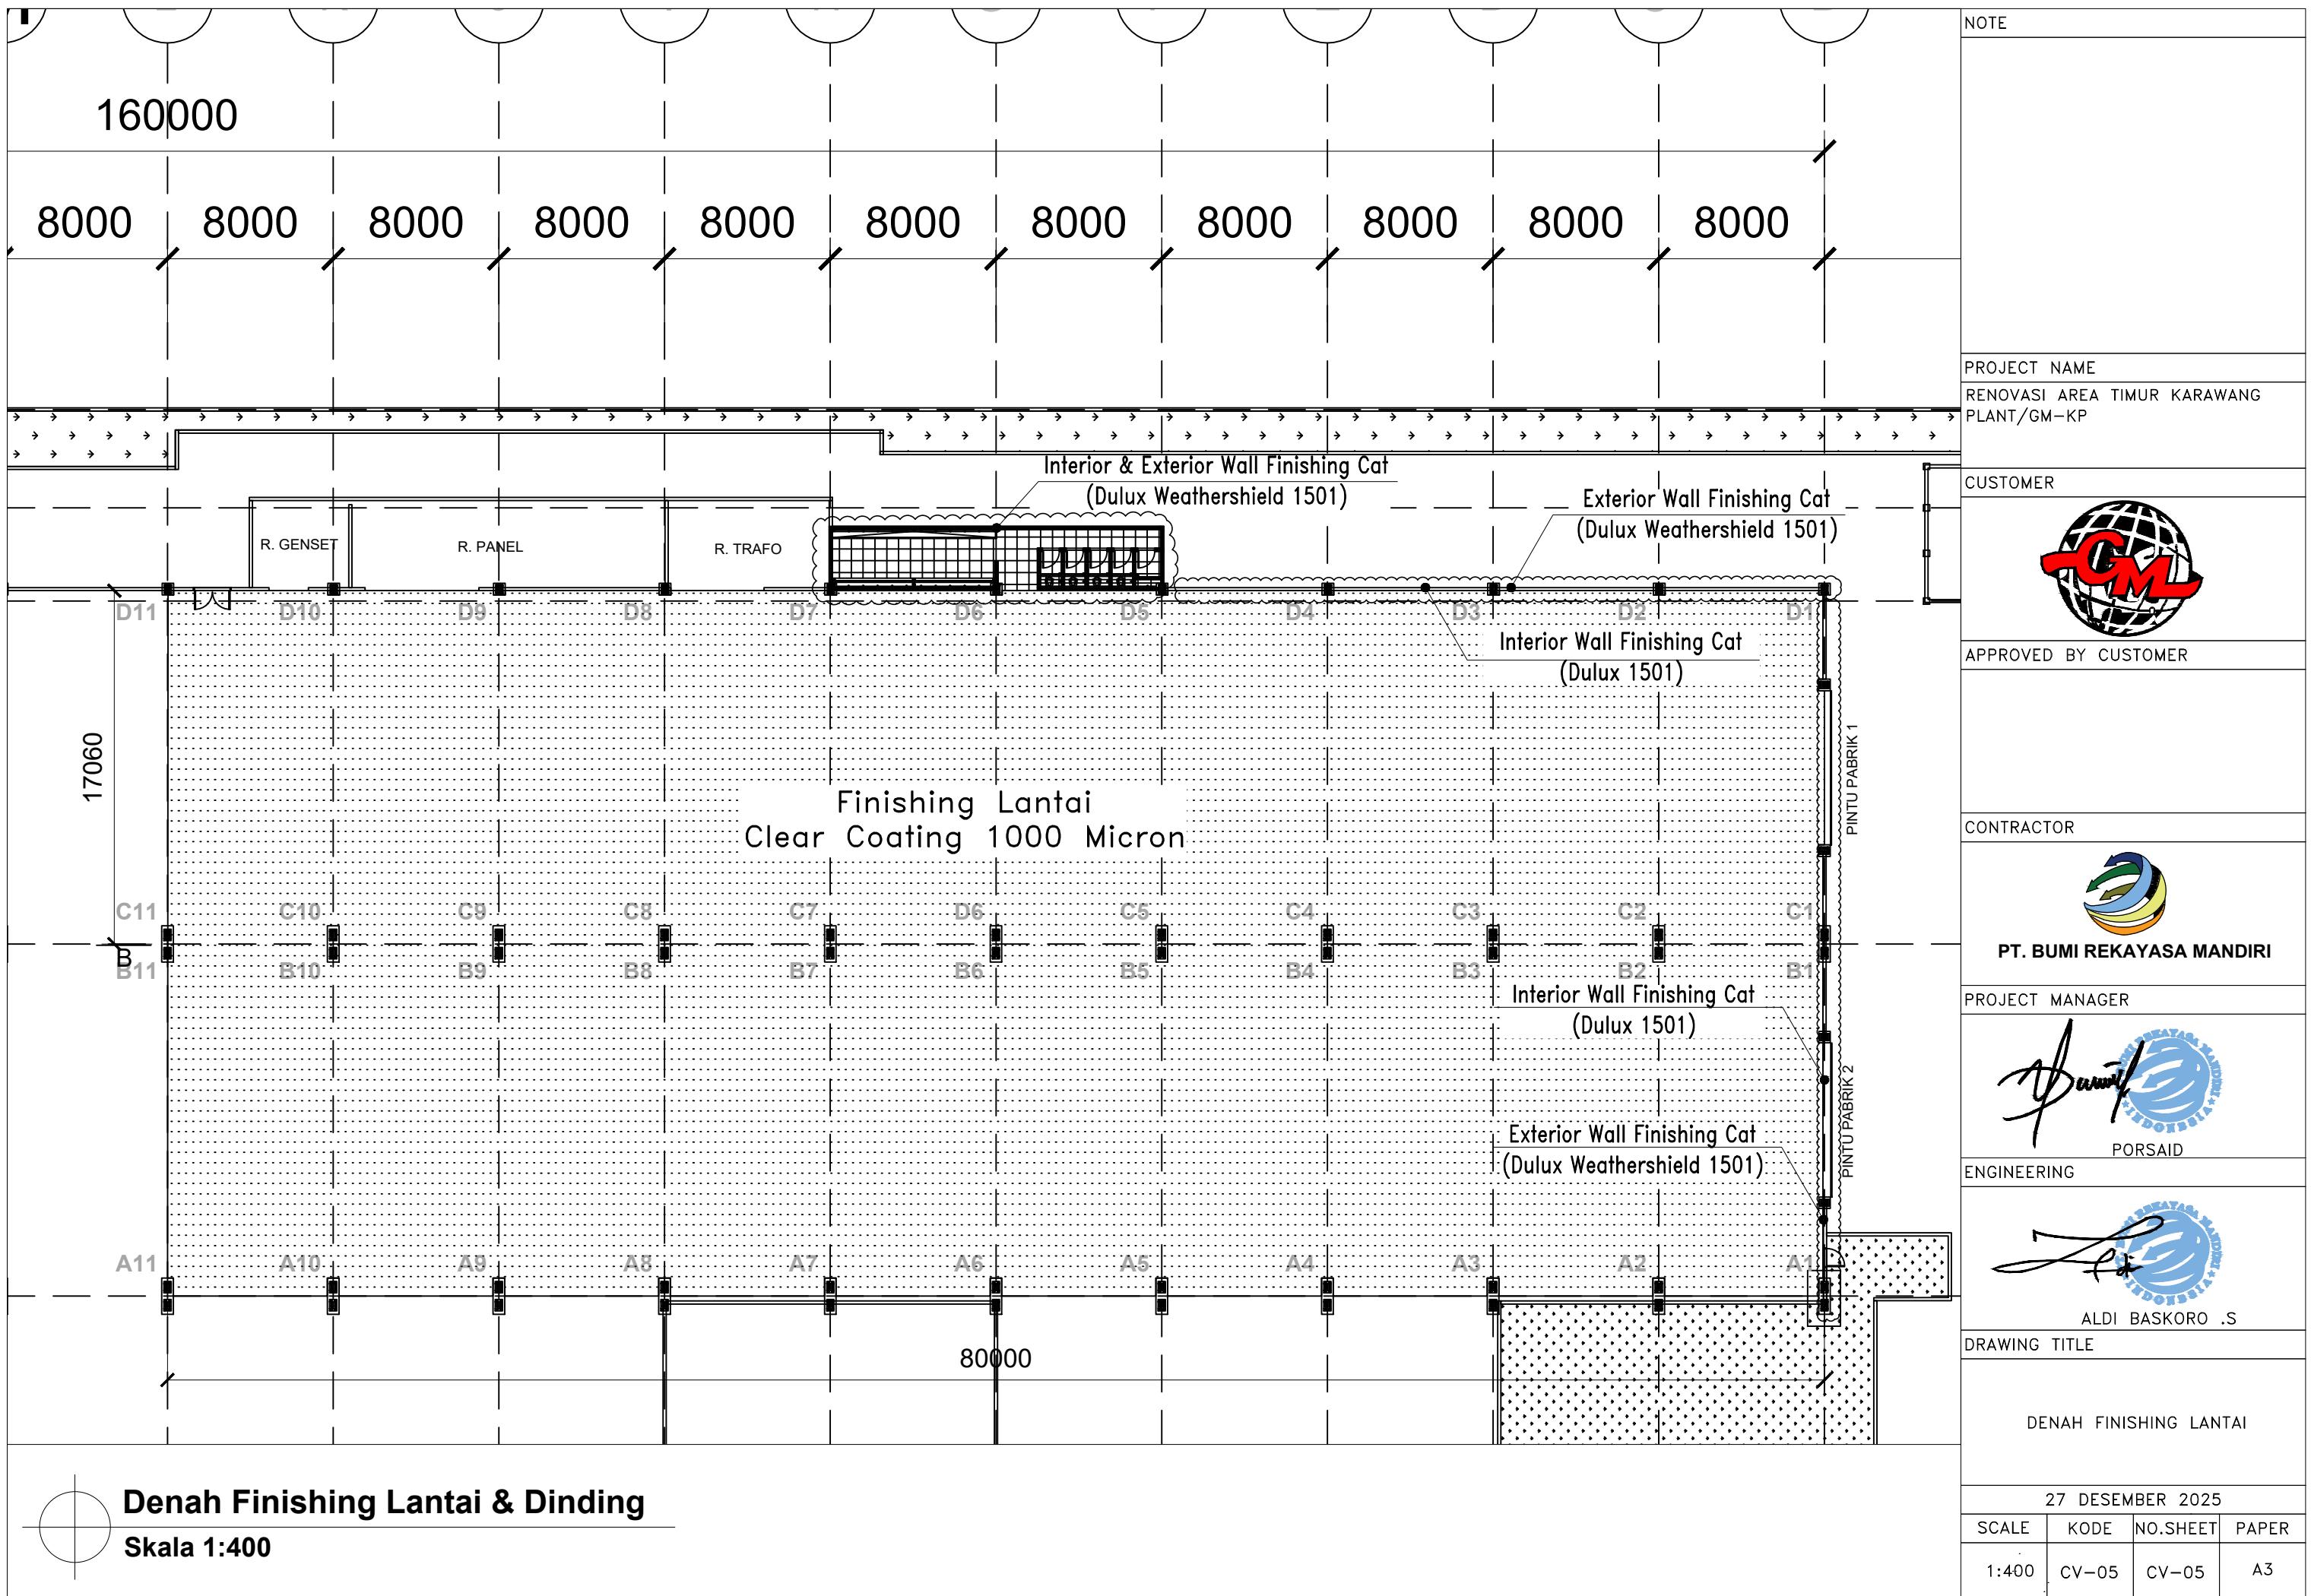

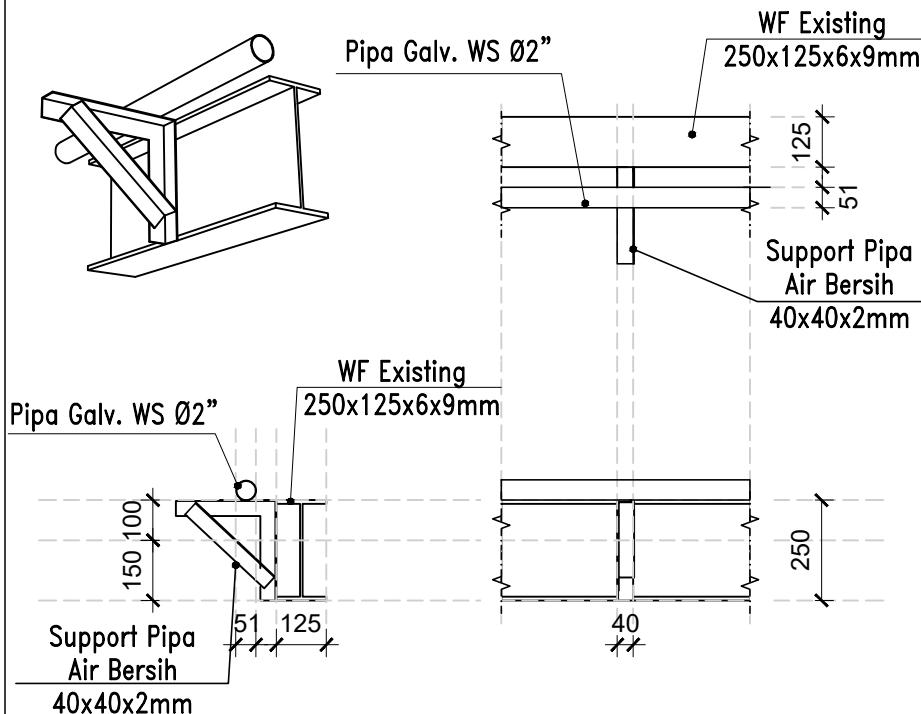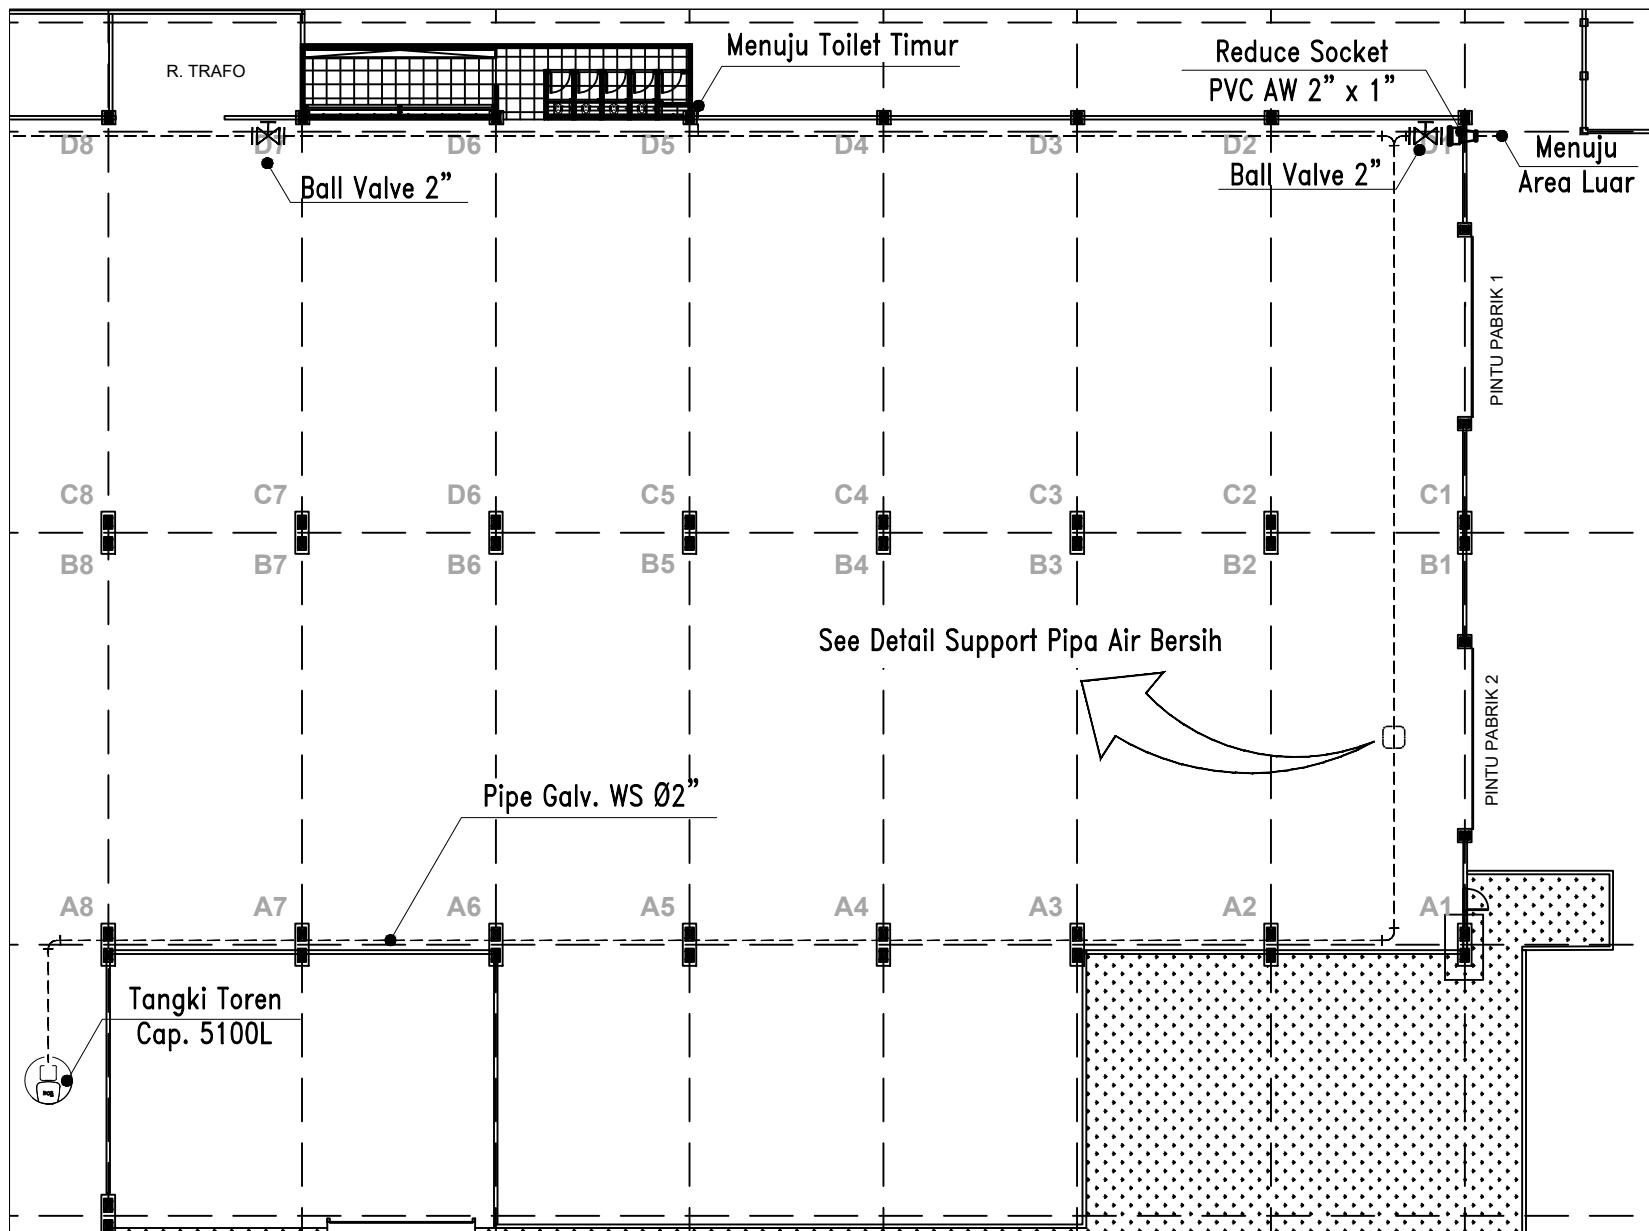


Detail Support Pipa Air Bersih
Skala 1:20

Denah Jalur Air Bersih (Area Produksi)
Skala 1:450


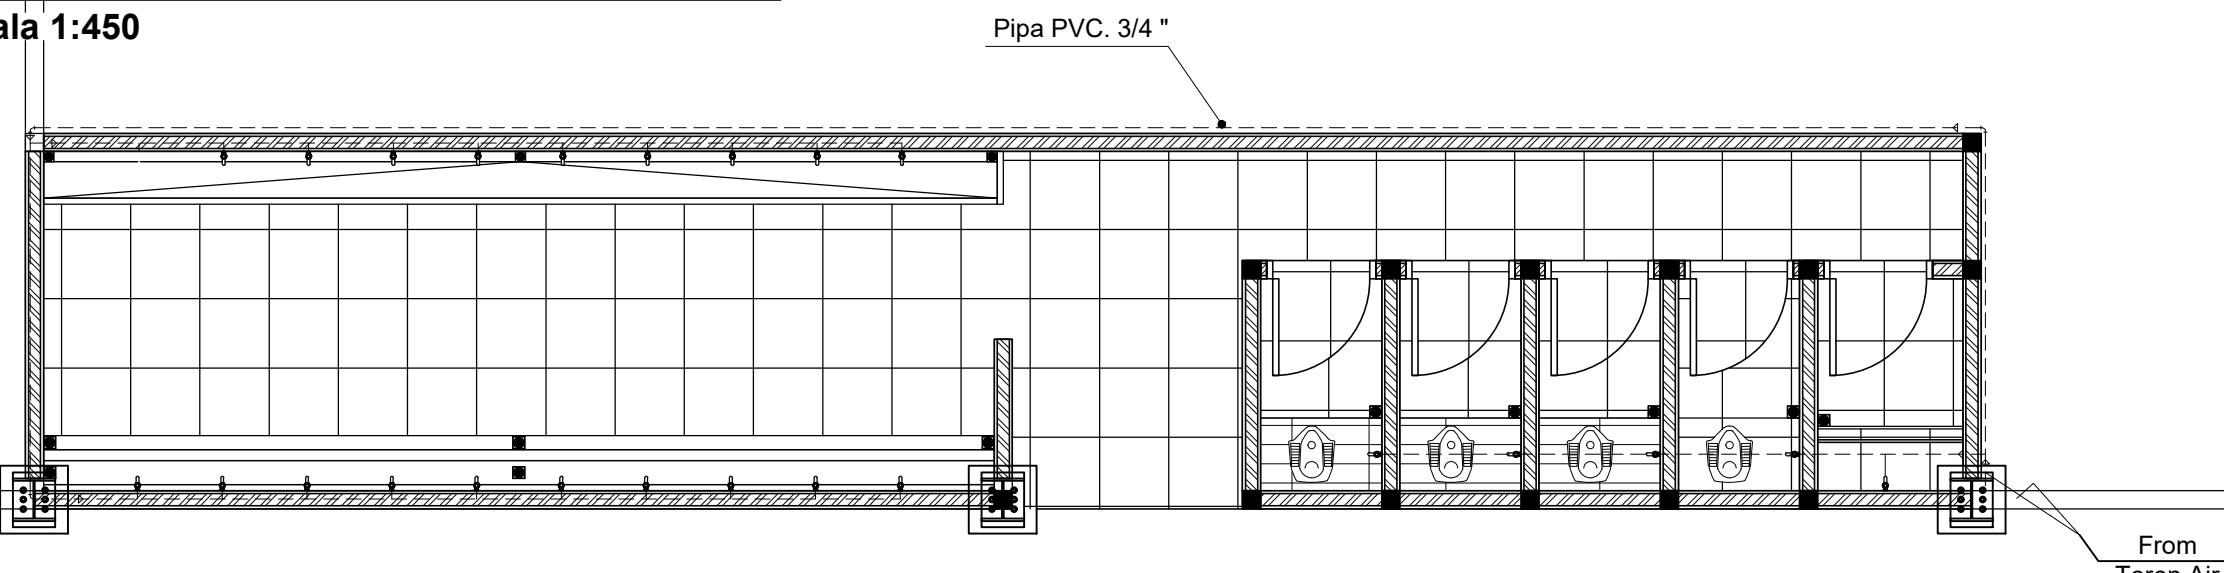


Denah Jalur Air Bersih (Area Toilet Timur)
Skala 1:100

NOTE			
PROJECT NAME	RENOVASI AREA TIMUR KARAWANG PLANT/GM-KP		
CUSTOMER			
APPROVED BY CUSTOMER			
CONTRACTOR			
PROJECT MANAGER	 PT. BUMI REKAYASA MANDIRI		
ENGINEERING	 PORSAID		
DRAWING TITLE	DENAH JALUR AIR BERSIH (AREA PRODUKSI) DENAH JALUR AIR BERSIH (AREA TOILET) DETAIL SUPPORT PIPA AIR BERSIH		
SCALE	KODE	NO.SHEET	PAPER
1:450 1:100 1:20	P-06	P-06	A3
27 DESEMBER 2025			

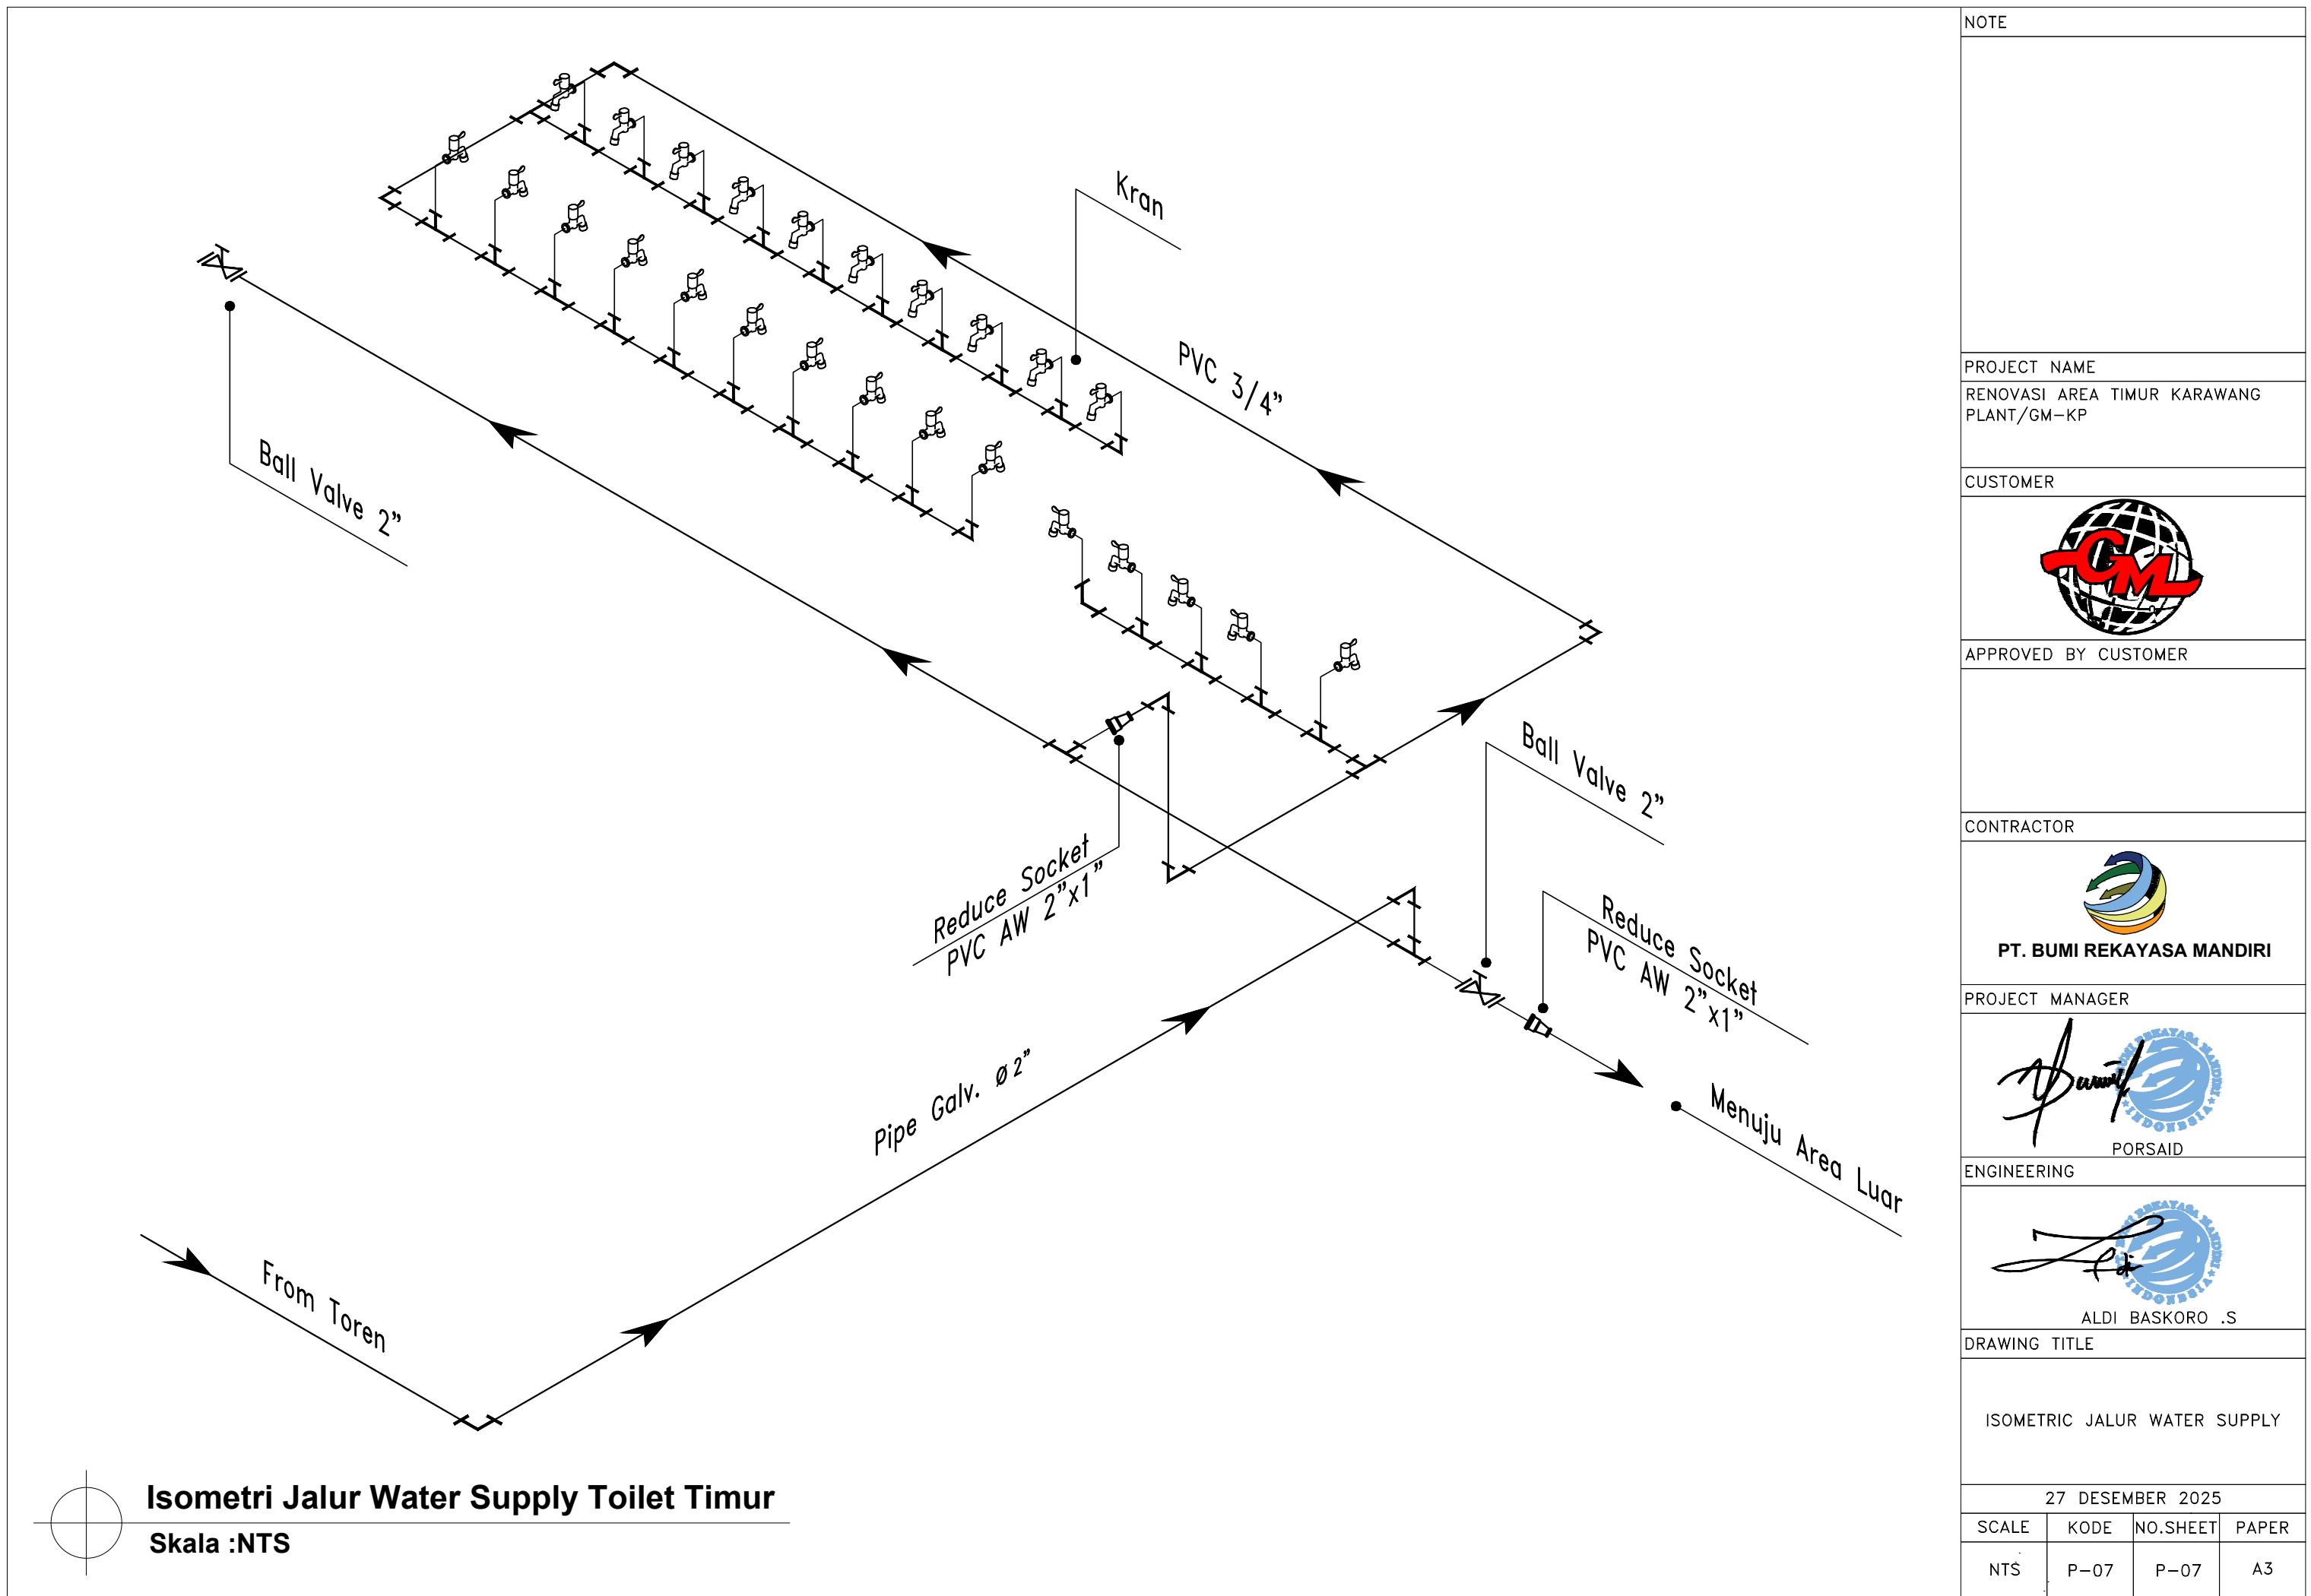

NOTE			
PROJECT NAME	RENOVASI AREA TIMUR KARAWANG PLANT/GM-KP		
CUSTOMER			
APPROVED BY CUSTOMER			
CONTRACTOR	 PT. BUMI REKAYASA MANDIRI		
PROJECT MANAGER	 PORSAID		
ENGINEERING	 ALDI BASKORO .S		
DRAWING TITLE	DENAH AIR KOTOR (AREA TOILET)		
27 DESEMBER 2025			
SCALE	KODE	NO.SHEET	PAPER
1:100	P-08	P-08	A3

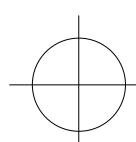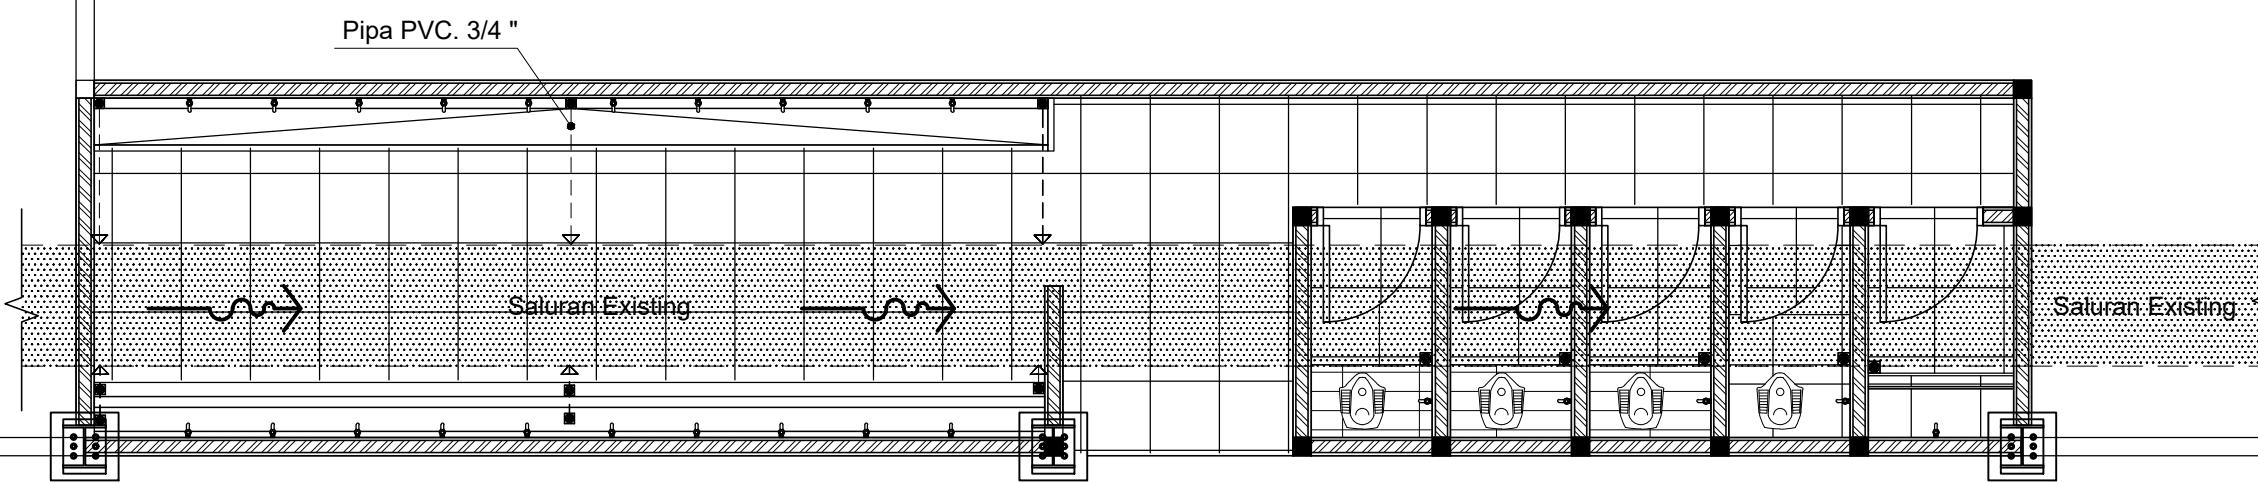


Denah Air Kotor (Area Toilet Timur)

Skala 1:100


NOTE	
PROJECT NAME	RENOVASI AREA TIMUR KARAWANG PLANT/GM-KP
CUSTOMER	
APPROVED BY CUSTOMER	
CONTRACTOR	 PT. BUMI REKAYASA MANDIRI
PROJECT MANAGER	 PORSAID
ENGINEERING	 ALDI BASKORO .S
DRAWING TITLE	DENAH ELEKTRIKAL(AREA TOILET) ISOMETRIK (AREA TOILET)
DATE	27 DESEMBER 2025
SCALE	KODE
1:100 NTS	NO.SHEET
	PAPER
	A3

LEGEND :	
SYMBOL	DESCRIPTION
---	Cable NYM 3x2,5 mm Supreme
	Saklar Double Outbow Legrand Plexo = 2 Pcs
	Lampu TL LED TKO 1x18 Philips = 8 Pcs

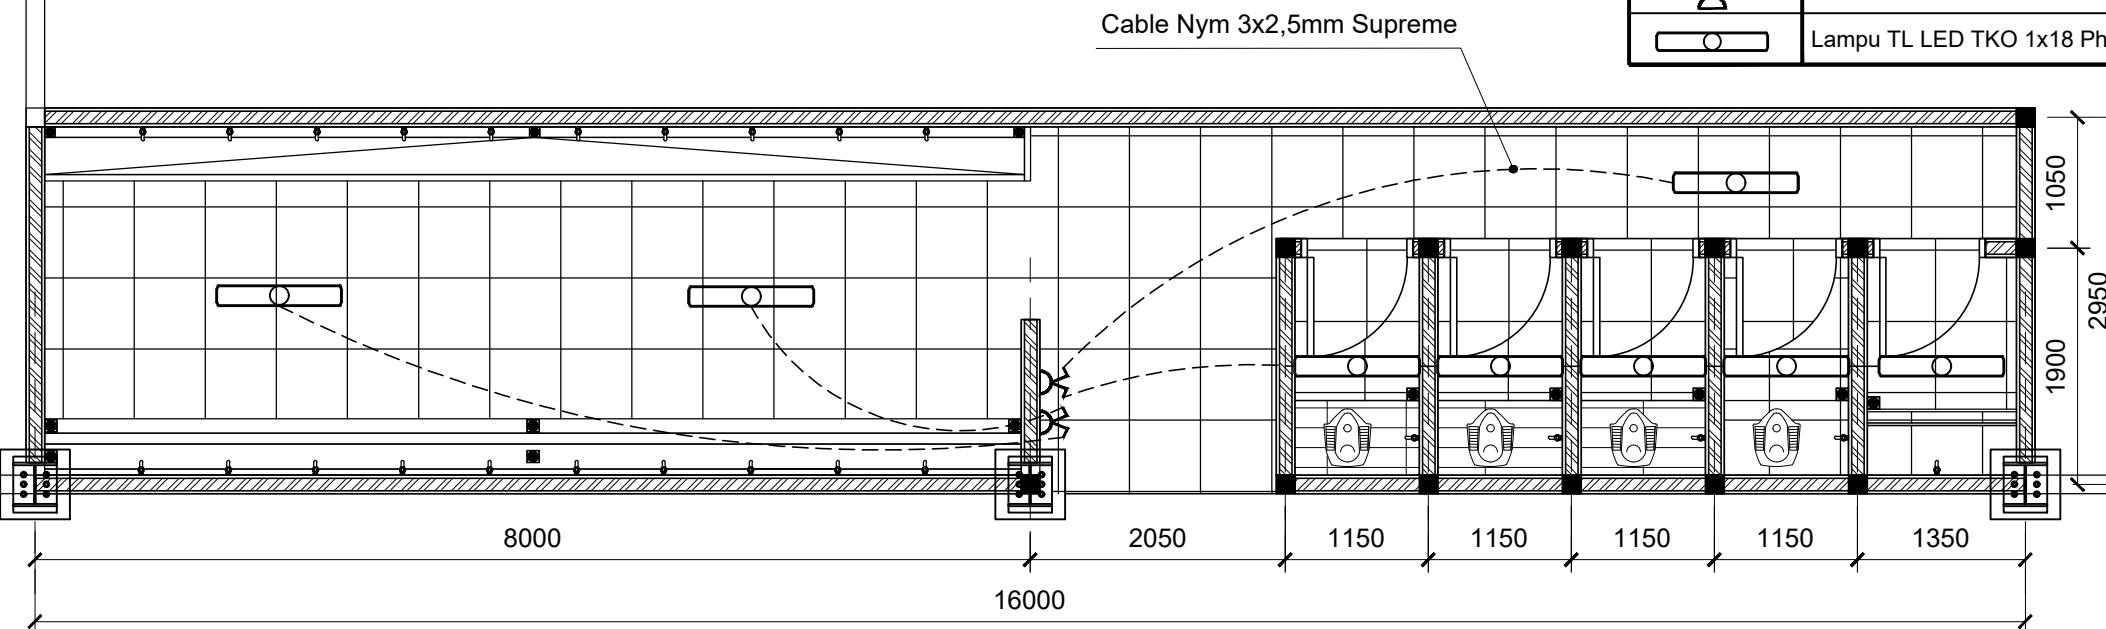


Denah Elektrikal (Area Toilet Timur)

Skala 1:100

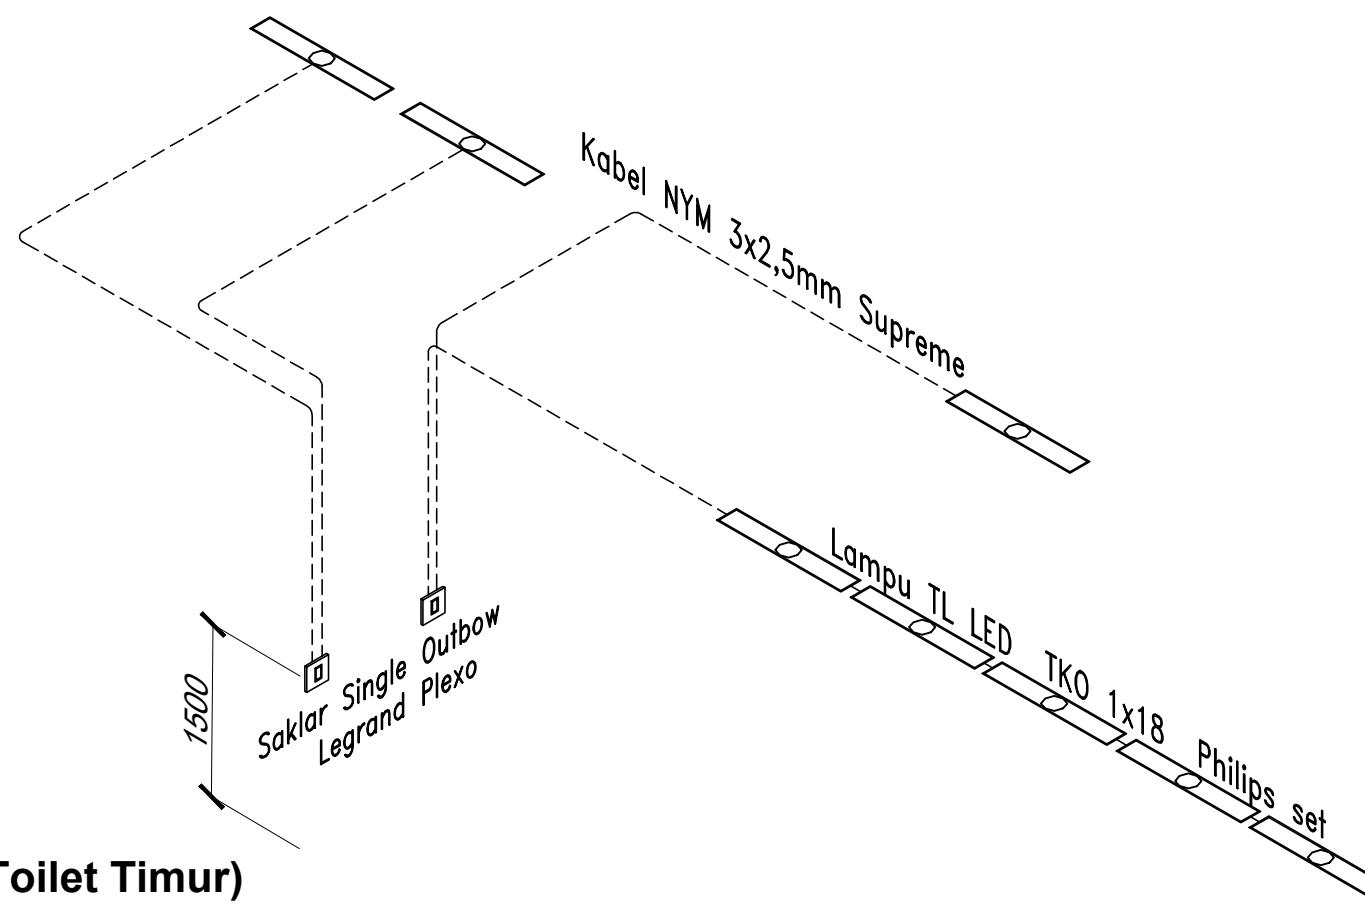

View Isometri (Area Toilet Timur)


Skala :NTS

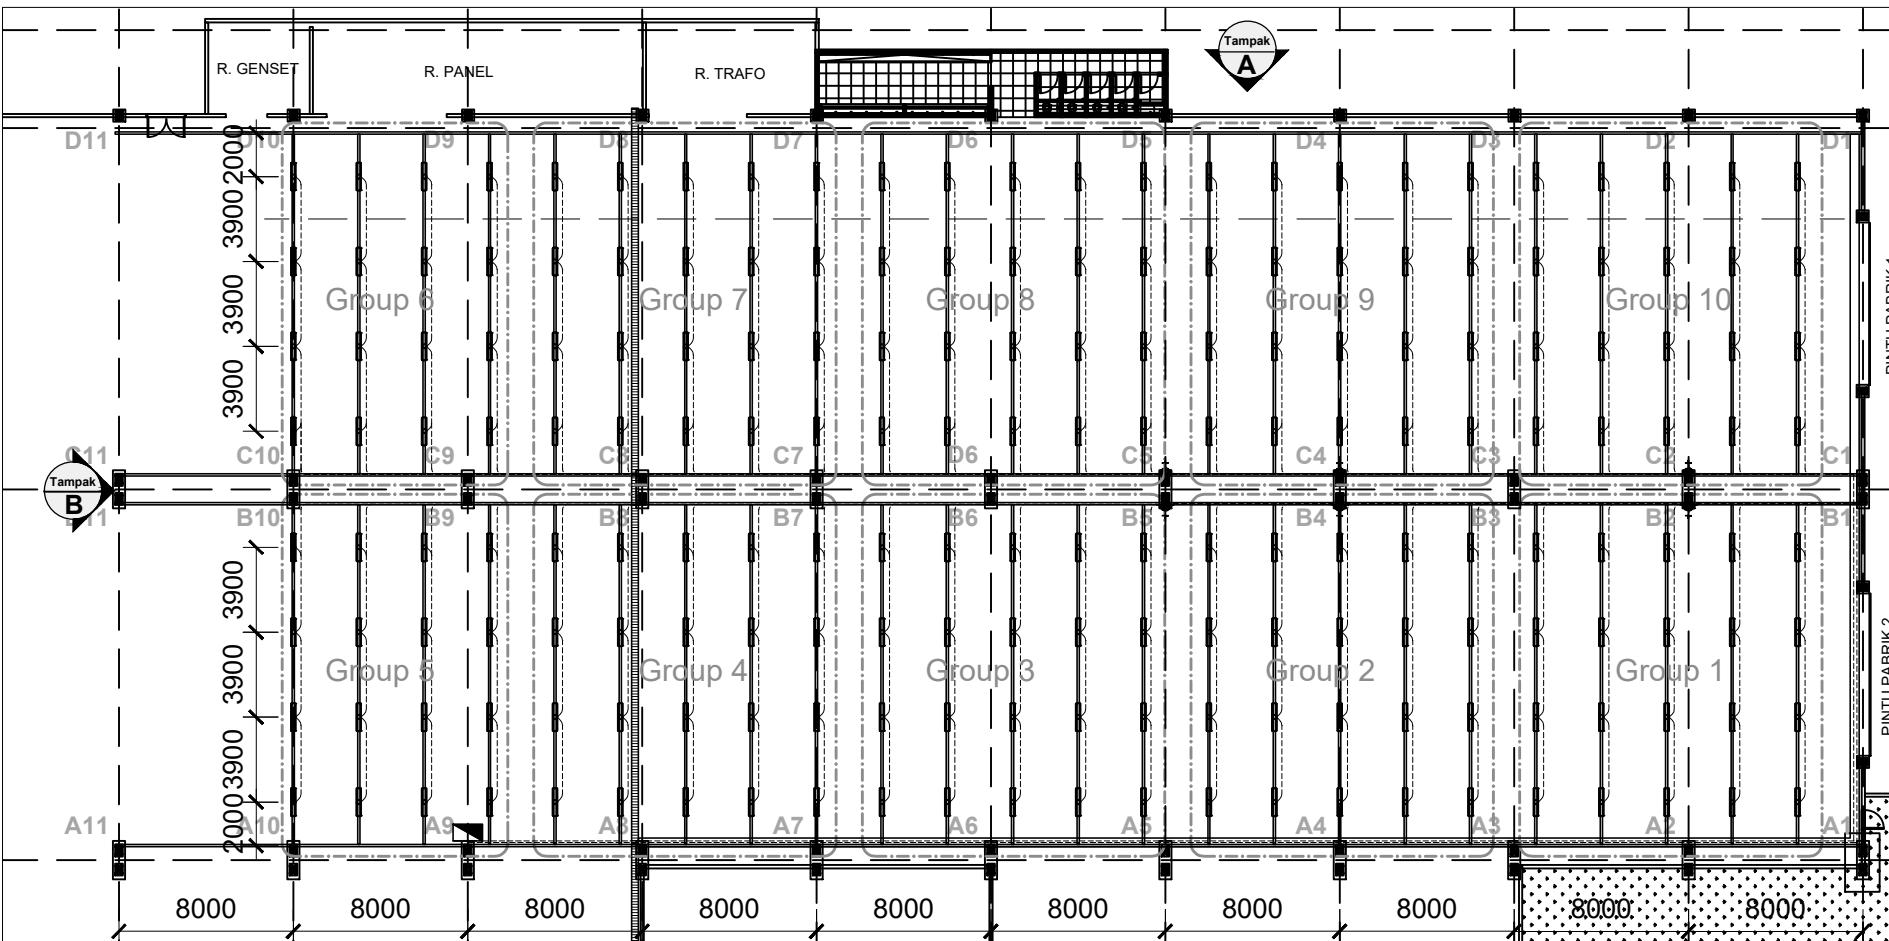


LEGEND :	
SYMBOL	DESCRIPTION
---	NYM 3x2,5 mm Supreme
- - -	NYM 3x2,5 mm Suprame
[]	Support Lampu CNP 100x50x20x2,3mm
[---]	Tray Cable 400x100 Galvanized
[--- ---]	Cable Leader 300x100 Galvanized
[--- --- ---]	Lampu TL LED TKO 1x18 Philips set = 192 Pcs
[+]	Stop Kontak Outbow Legrand Plexo = 6 Pcs
[■]	Panel SDP Junbiki 01

NOTE
PROJECT NAME : RENOVASI AREA TIMUR KARAWANG PLANT/GM-KP
CUSTOMER : 
APPROVED BY CUSTOMER

Denah Elektrikal (Area Produksi)
Skala 1:500

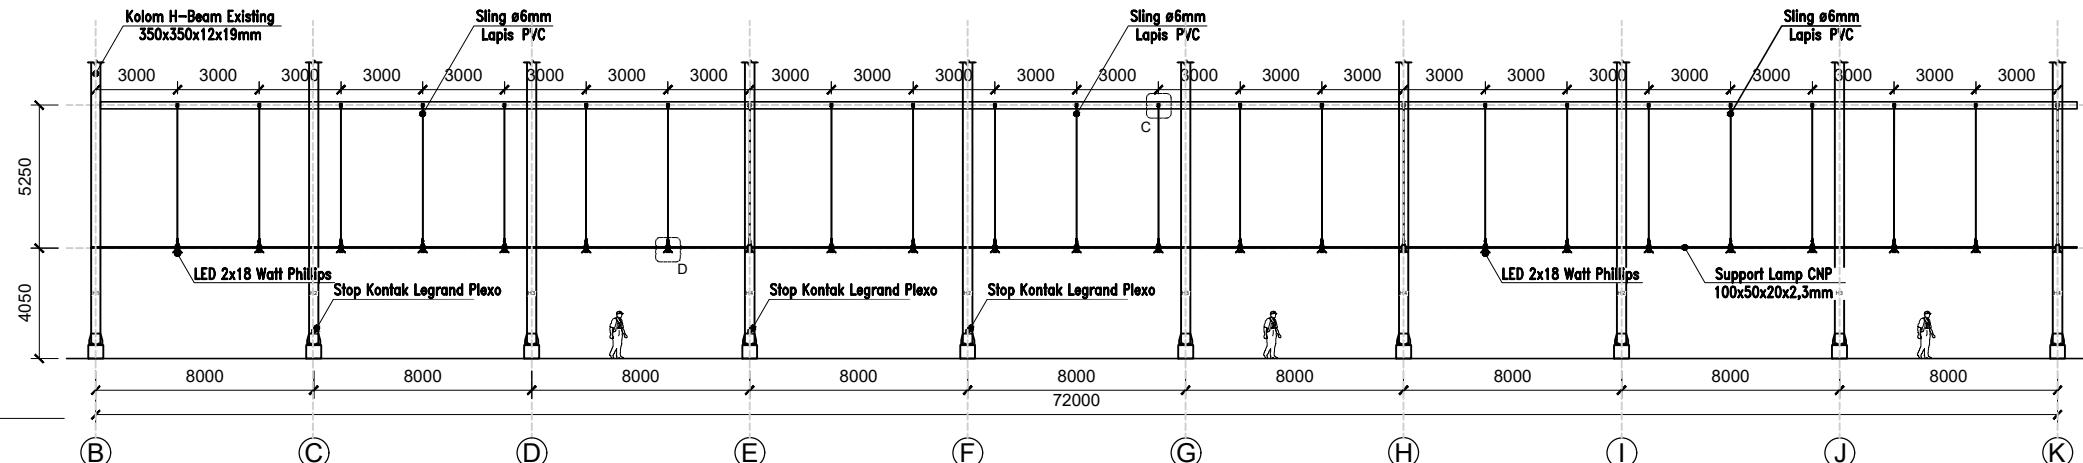

Tampak A
Skala 1:400

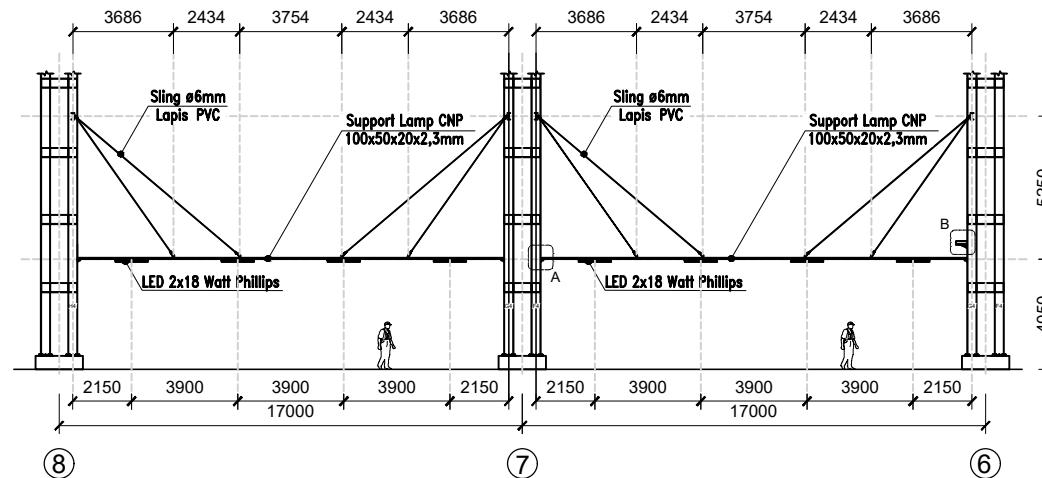

Tampak B
Skala 1:400

CONTRACTOR : 
PT. BUMI REKAYASA MANDIRI
PROJECT MANAGER : 


PORSAID : 
PORSAID

ENGINEERING : 
ALDI BASKORO .S
DRAWING TITLE


DENAH ELEKTRIKAL
TAMPAK A
TAMPAK B

27 DESEMBER 2025

SCALE	KODE	NO.SHEET	PAPER
1:500	E-10	E-10	A3
1:400			
1:400			

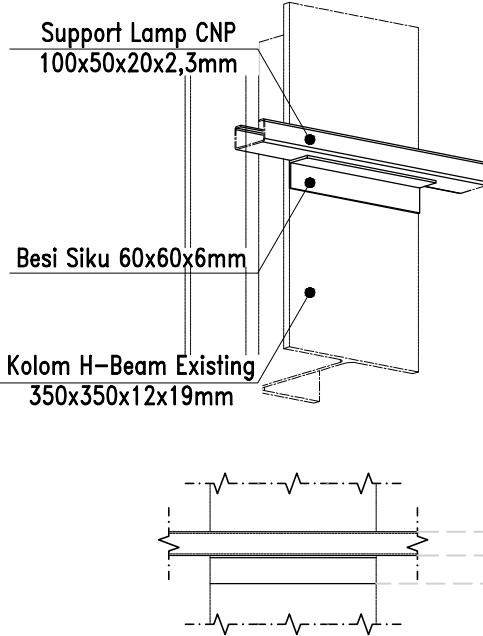


Detail A
Skala 1:20

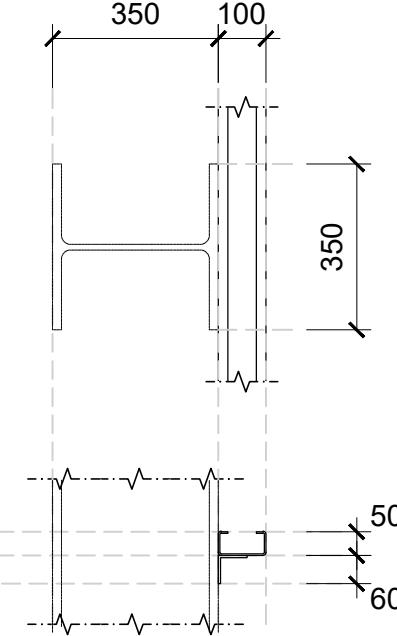

Detail B


Skala 1:20

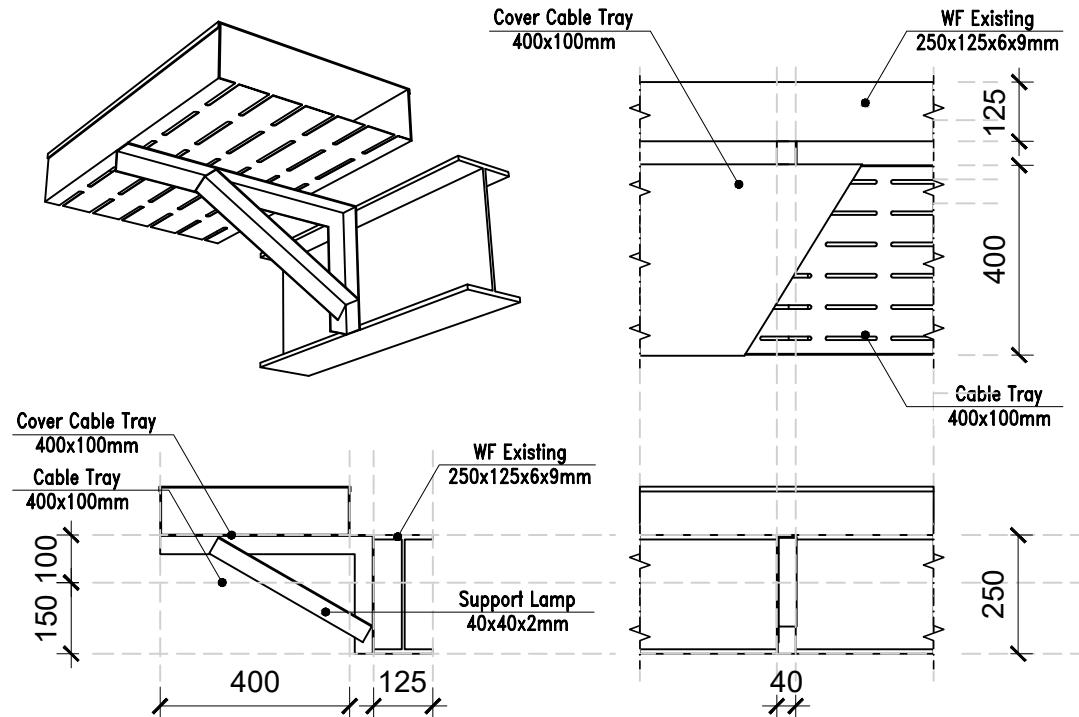


NOTE	
PROJECT NAME	RENOVASI AREA TIMUR KARAWANG PLANT/GM-KP
CUSTOMER	
APPROVED BY CUSTOMER	



APPROVED BY CUSTOMER

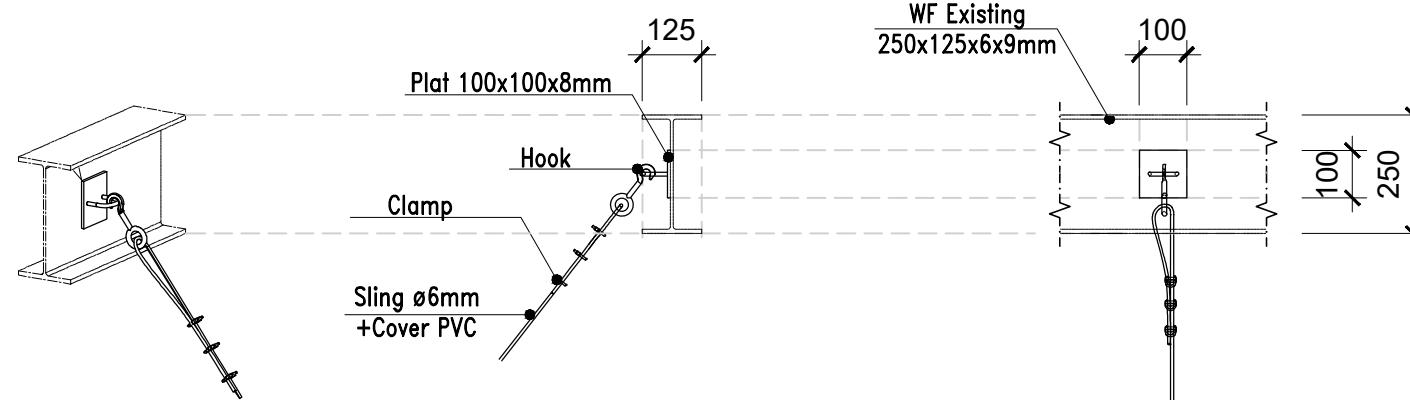

Detail C
Skala 1:20

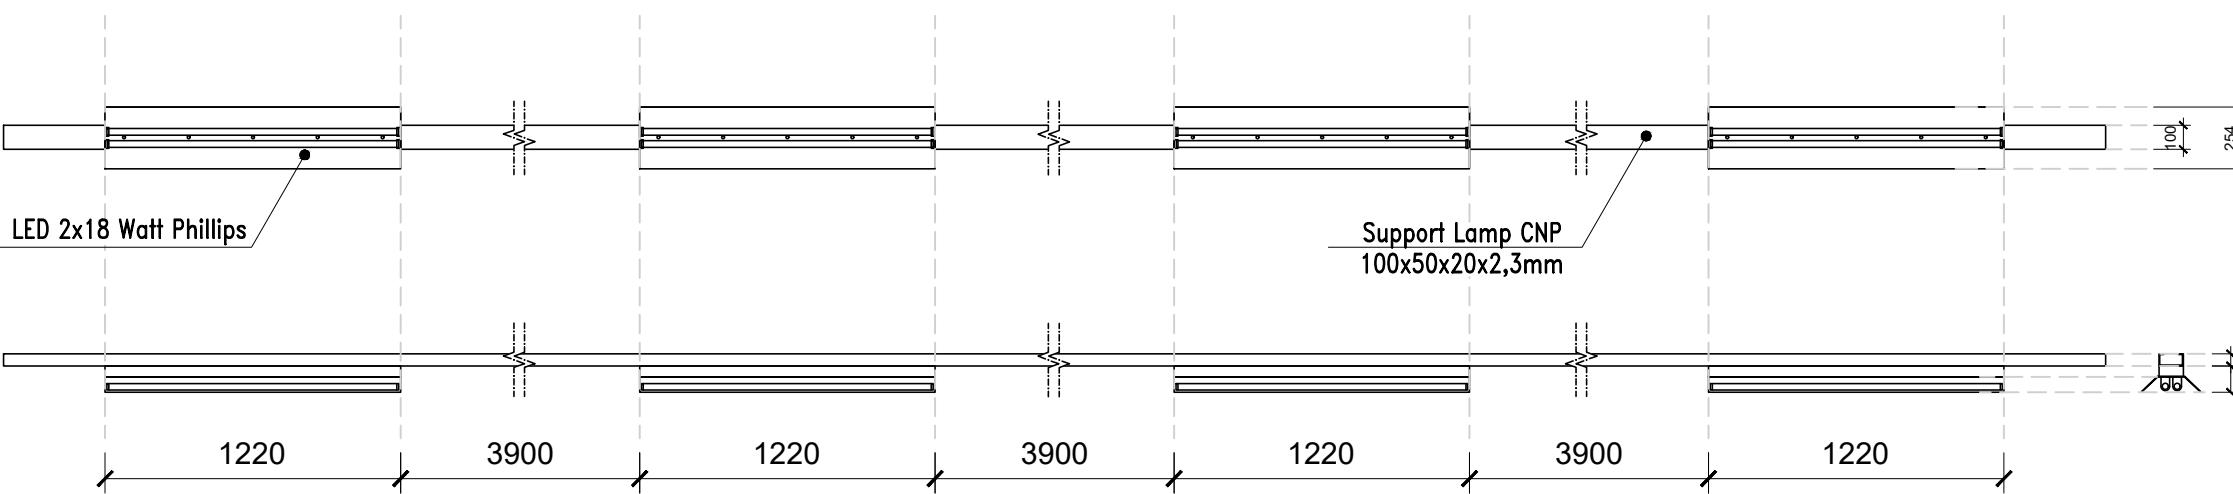

Detail D
Skala 1:45

PT. BUMI REKAYASA MANDIRI

PROJECT MANAGER


A composite image featuring a black ink signature of the name "Danny" on the left and a circular blue logo on the right. The logo contains the text "DANIEL PORSAID" around the top and "PORSAID" at the bottom, with a stylized globe graphic in the center.

DRAWING TITLE

DETAIL SUPPORT LAMP & KABEL TRAY

27 DESEMBER 2025


SCALE	KODE	NO.SHEET	PAPER
1:20 1:45	E-11	E-11	A3

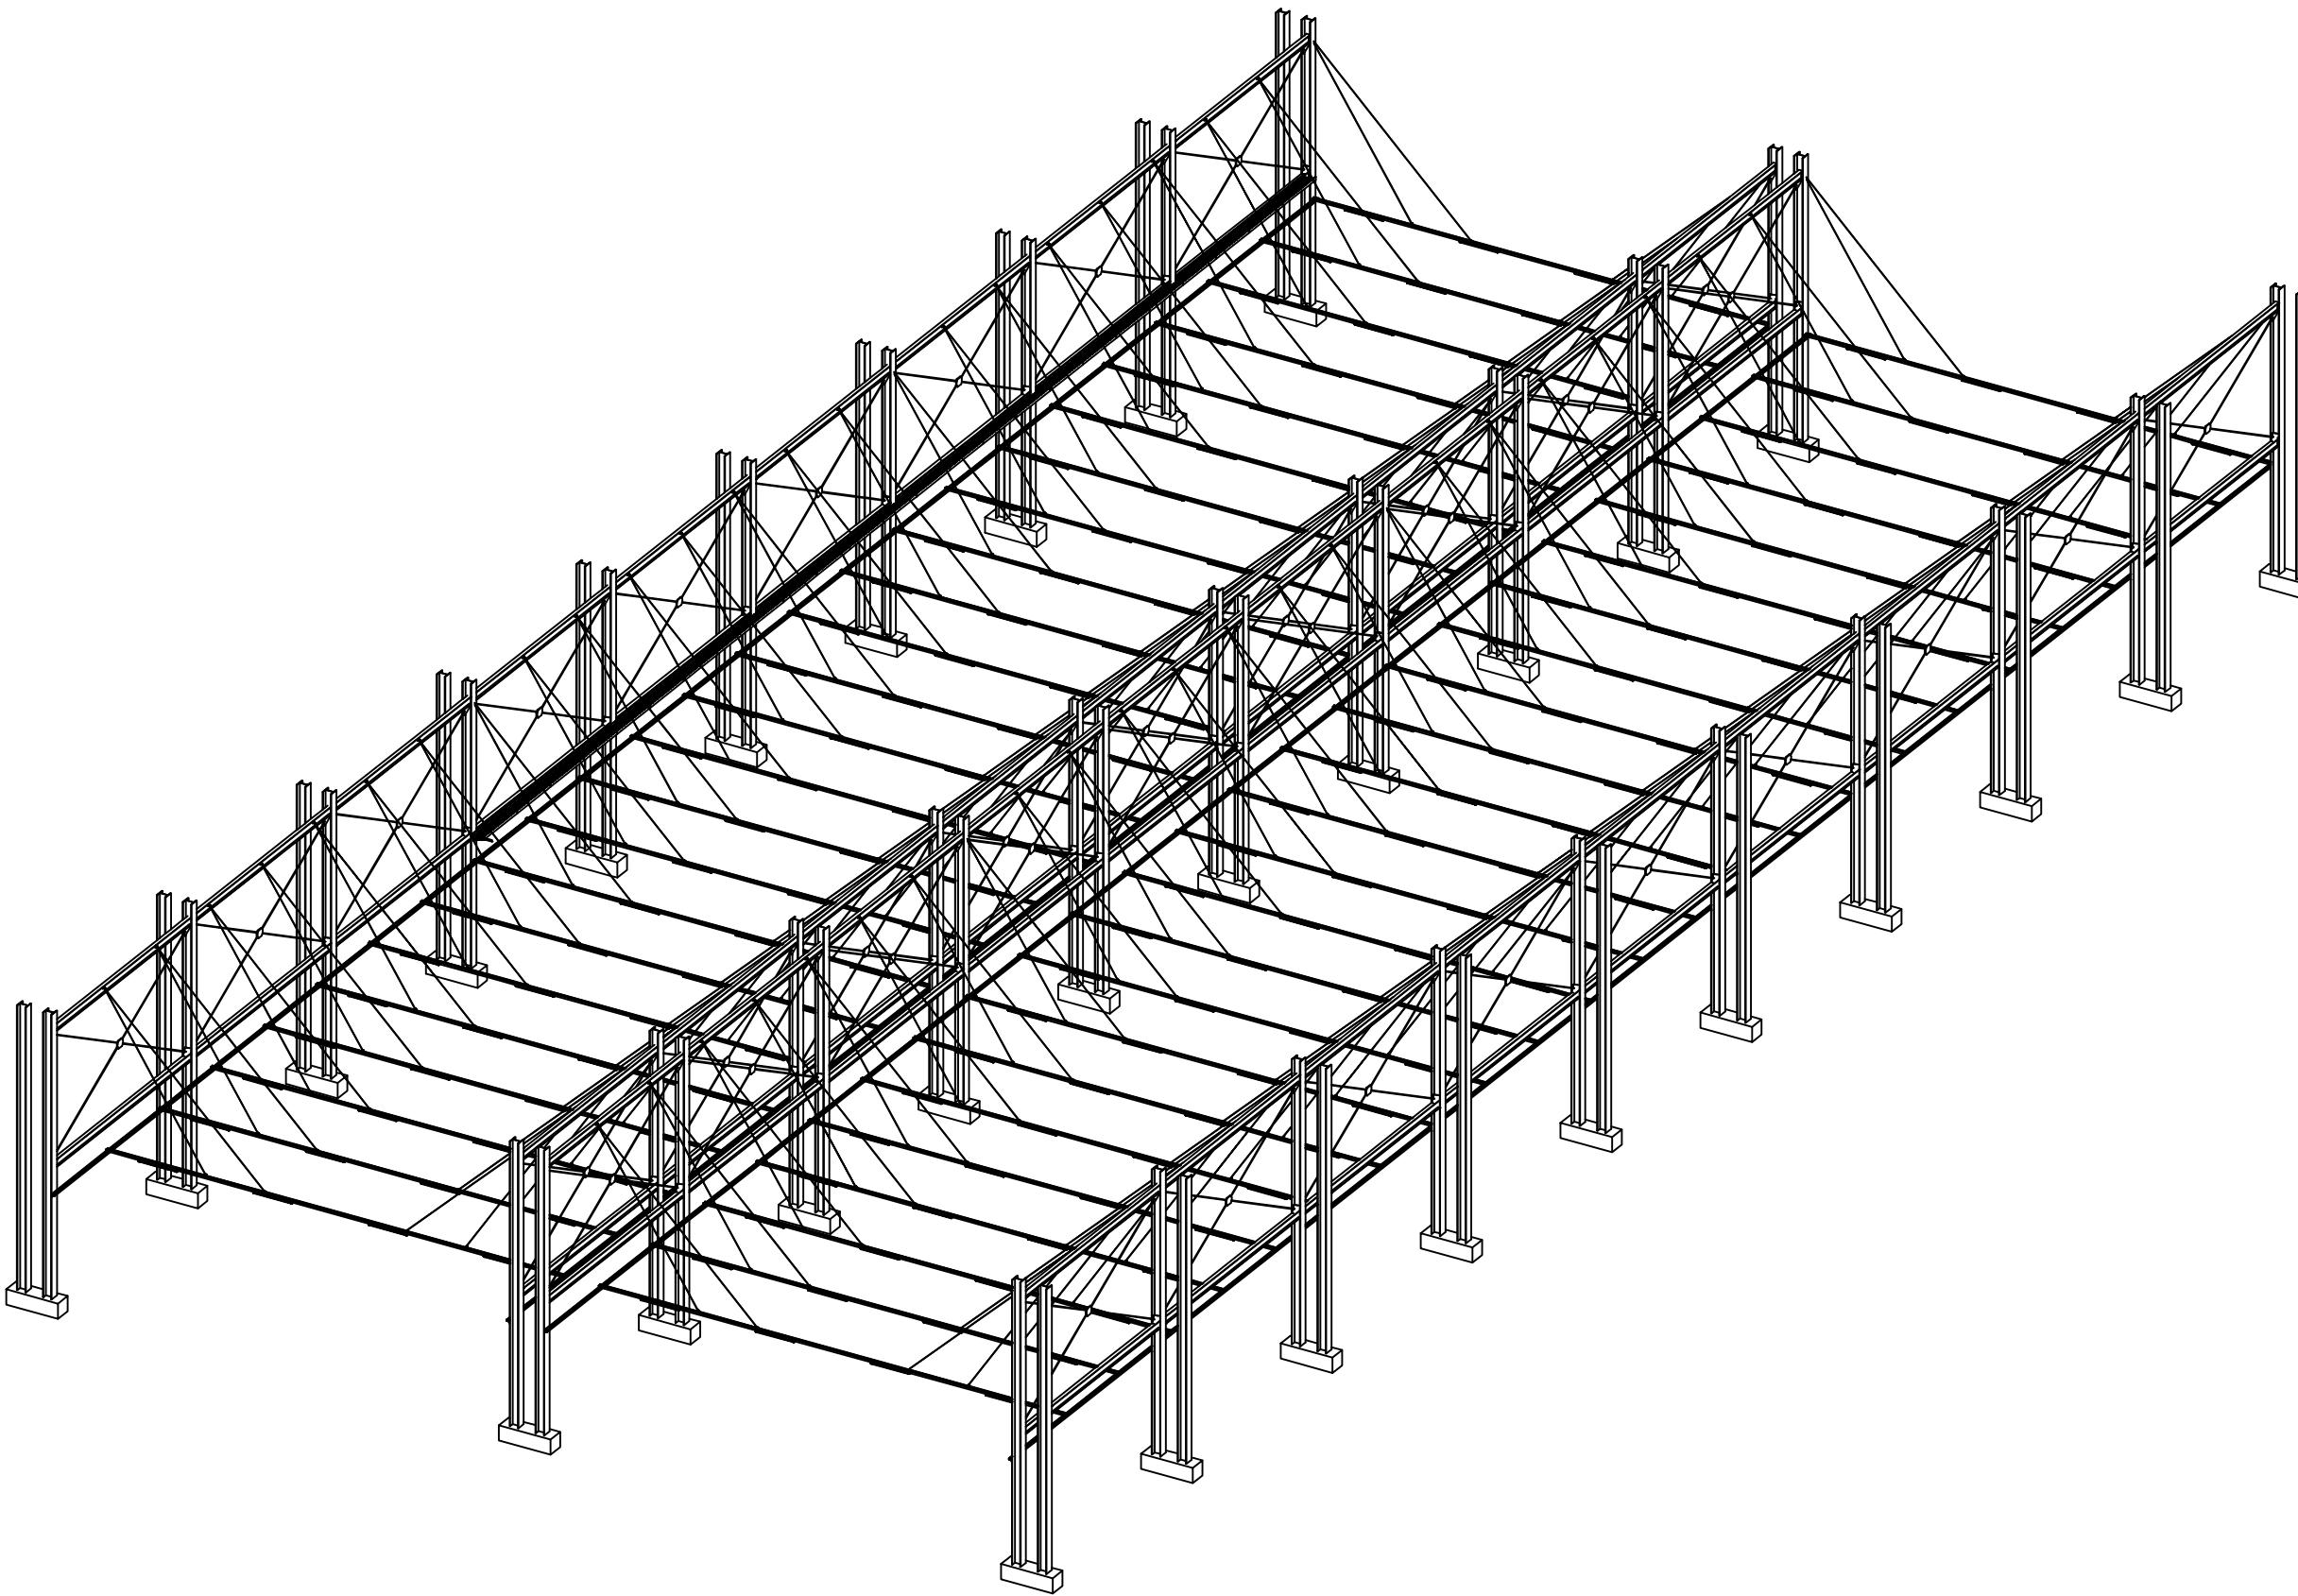

Isometric Support Lamp

Skala :NTS

NOTE			
PROJECT NAME	RENOVASI AREA TIMUR KARAWANG PLANT/GM-KP		
CUSTOMER			
APPROVED BY CUSTOMER			
CONTRACTOR	 PT. BUMI REKAYASA MANDIRI		
PROJECT MANAGER	 PORSAID		
ENGINEERING	 ALDI BASKORO .S		
DRAWING TITLE	ISOMETRIC SUPPORT LAMP		
27 DESEMBER 2025			
SCALE	KODE	NO.SHEET	PAPER
NTS	E-12	E-12	A3

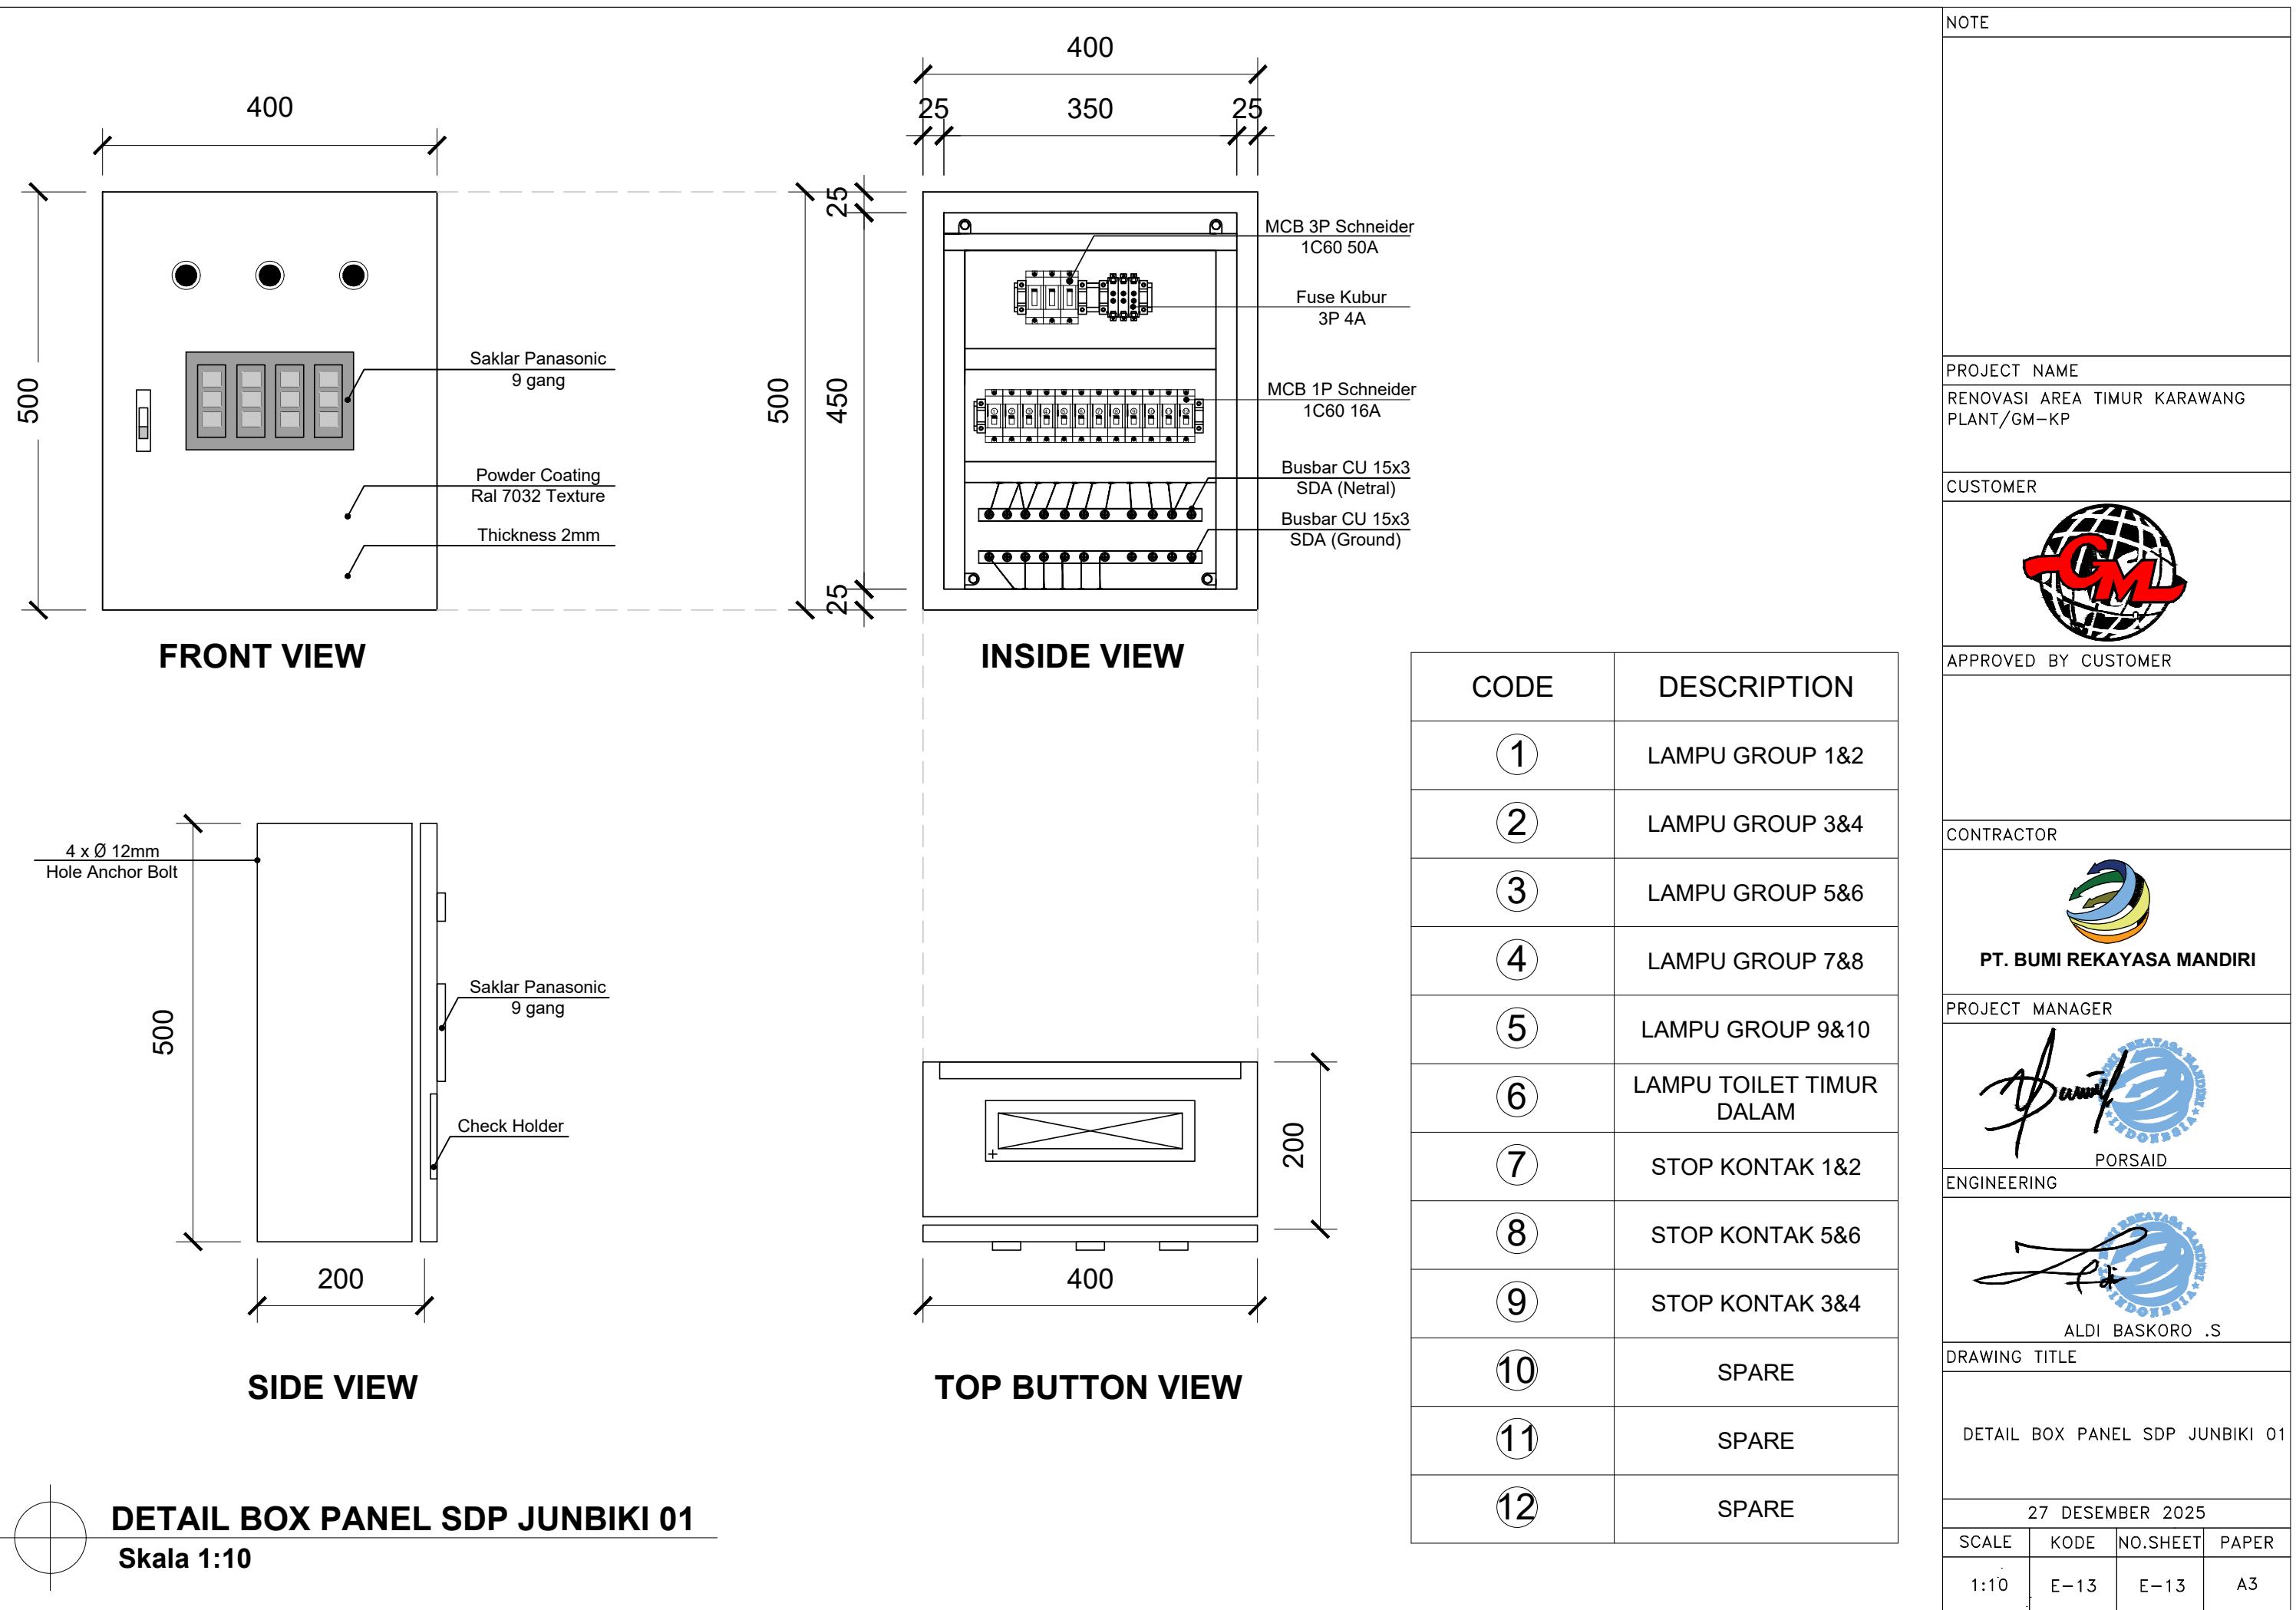

SPECIFICATION PANEL SDP JUNBIKI 01

No.	CODE	SPECIFICATION	BRAND	TYPE	QTY
1	Panel Future Timur New Junbiki				
1		Box : 40 x 50 x 20 Thickness 2mm Powder Coating Real 7032	Utama Panel	Indoor	1
		INCOMING			
2		MCB 3P 50A	Schneider	IC 60	
3		Fuse Kubur 10A	Fort	FS-101	3
4		Saklar Panasonic	Panasonic	Wnj 12G	1
5		Pilot Lamp 22mm AC220V R	Fort	CRP-22 ar	3
6		Sisir MCB	Fort	3 Phase	1
7		Kabel Power (50A)	Supreme	NYAF 6mm	1 Lot
8		Kabel Control	Supreme	NYAF 1,5mm	1 Lot
		Cell			
9		MCB 1P 16A	Schneider	IC 60	12
		CU BUSBAR			
10		CU BUSBAR (Netral/grounding)	Lokal	3 x 15 mm	1 Lot

NOTE				
PROJECT NAME	RENOVASI AREA TIMUR KARAWANG PLANT/GM-KP			
CUSTOMER				
APPROVED BY CUSTOMER				
CONTRACTOR				
PROJECT MANAGER	PT. BUMI REKAYASA MANDIRI			
ENGINEERING	 PORSAID			
DRAWING TITLE	ALDI BASKORO .S			
SINGLE LINE DIAGRAM				
SPECIFICATION BOX PANEL				
27 DESEMBER 2025				
SCALE	KODE	NO.SHEET	PAPER	
NTS	E-14	E-14	A3	

PANEL LP/PP SDP JUNBIKI 01

